

ADDENDUM NO. 2

Issued Date: March 11, 2021

**New Apartment Complex:
Zumbrota Apartments**
Zumbrota, MN

Architect's Project No. 2037

OWNER:

Keller-Baartman VII, LLC
1479 Hay Creek Valley Road
PO Box 31
Red Wing, MN 55066

ARCHITECT:

HMA Architects, Ltd.
700 W. St. Germain Street, Suite 200
St. Cloud, MN 56301-3507
T: 320.251.9155

STRUCTURAL ENGINEER:

Sandman Structural Engineers
1587 30th Avenue South
Moorhead, MN 56560
T: 218.227.0022

CIVIL ENGINEER:

Johnson-Scofield Land Surveying & Engineering
1203 Main Street
Red Wing, MN 55066
T: 651.388.1558
Contact: Steven Voigt, PE

SCOPE OF ADDENDUM:

This addendum shall be appended to, and shall take precedence over, and be considered a part of the drawings and specifications for the above project.

Contractors and subcontractors are responsible for reviewing this addendum and coordinating the changes or clarifications of this addendum with the Contract Documents, including those changes set forth in this addendum which inadvertently affects other areas of the Contract Documents.

CHANGES TO ARCHITECTURAL DRAWINGS: (drawings with revision dated 03/09/2021)

1. Sheet A501, A503, A504, A505, A506:
 - a. Exterior Wall Types:
 - i. Revise minimum R-value for wall types WE-3, WE-4, WE-4A to **R-13.3ci**.
2. See revised civil engineering drawings from Johnson & Scofield, Inc. dated 3-11-2021, Addendum #2 (delta tag 2). Revisions are indicated with red highlight.
 - a. Add detail for roof drain system showing cleanout sizes and locations in both the lead and main pipes.
 - b. Revise garage floor drain pipe material from SDR 26 to Schedule 40.
 - c. Revise sanitary sewer detail changing from outside drop to inside drop manhole.
 - d. Add RIM elevations for SSMH1 and STMH1.


THIS ADDENDUM SHALL BECOME A PART OF THE BID. THE BIDDER SHALL INSERT THE ADDENDUM NUMBER IN THE SPACE WHERE INDICATED ON THE PROPOSAL FORM. FAILURE TO COMPLY MAY RESULT IN THE BID BEING REJECTED.

700 W. St. Germain Street
Suite 200
St. Cloud, MN 56301-3507

T | 320.251.9155
F | 320.251.4919

END OF ADDENDUM

Attachments: A501, A503, A504, A505, A506, civil drawings sheets 1-29.

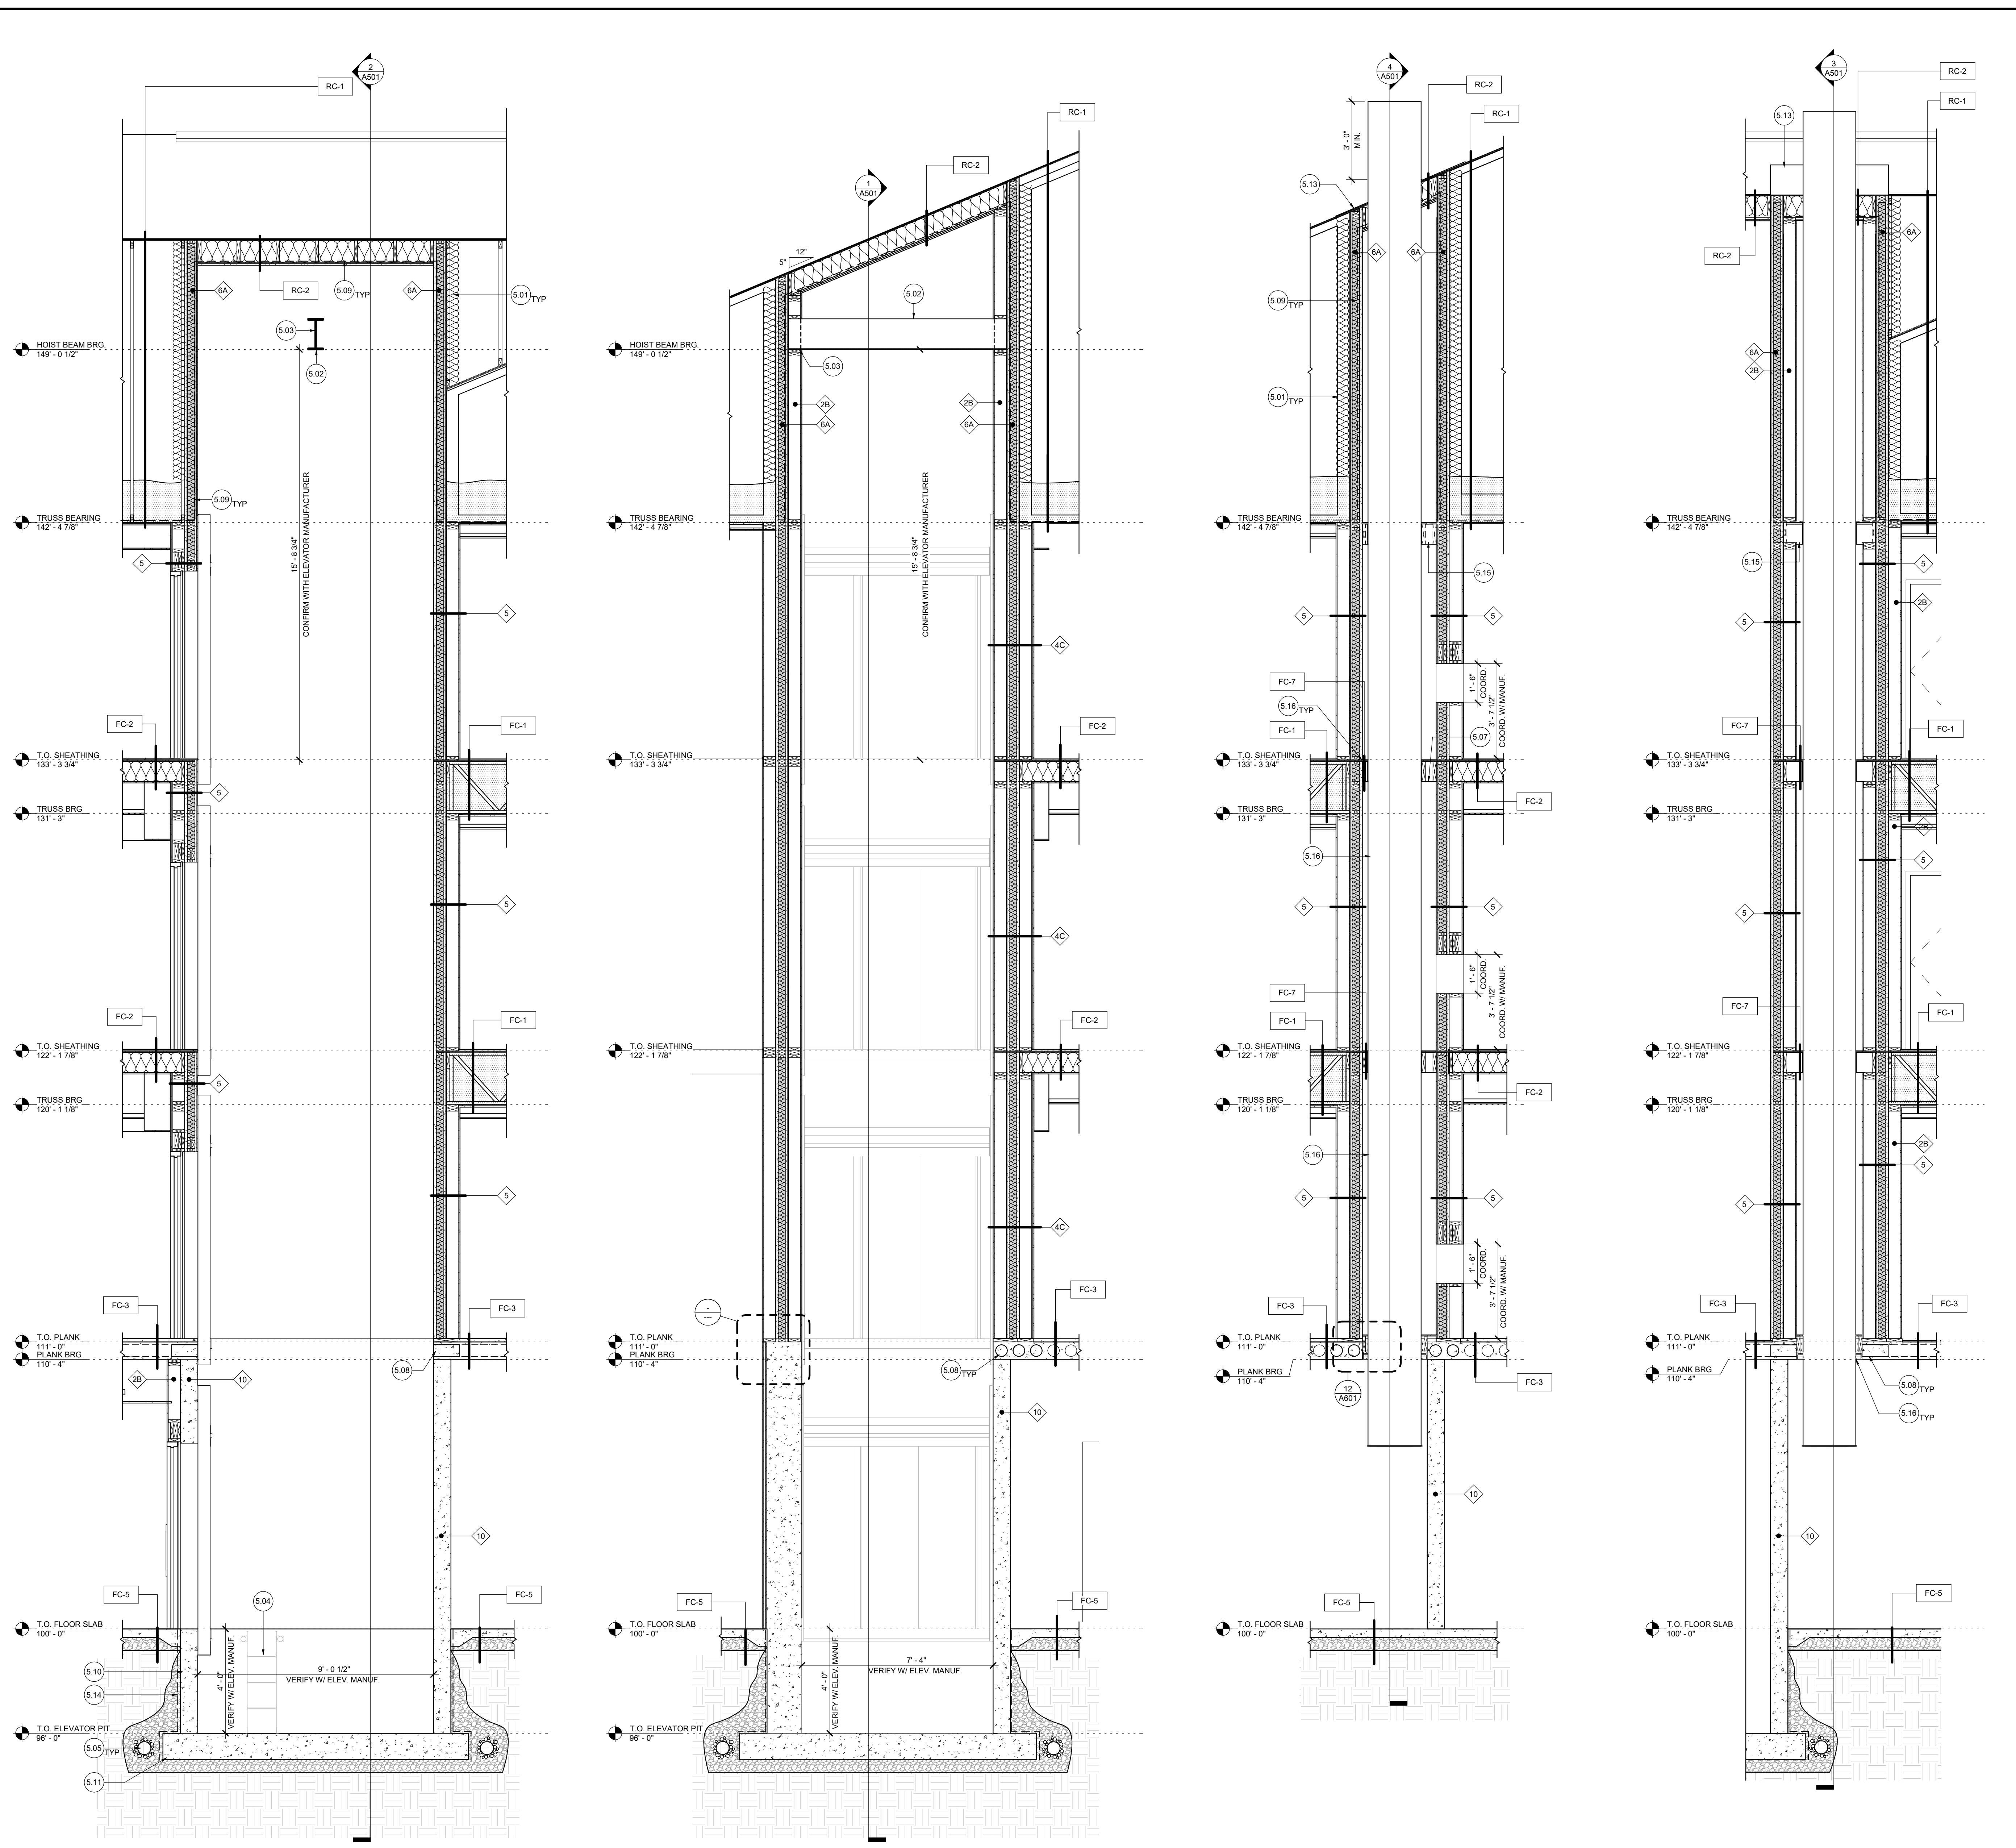

EXTERIOR WALL TYPES

EXTERIOR SIDING / TRIM. SEE ELEVATIONS. 1/2" EXT. WALL SHEATHING W/ INTEGRAL W.R.B. (EXP. 1, SEE STRUCT.) R-21 UNFACED BATT INSUL. 2x6 WD. STUDS (SEE STRUCT.) POLY VAPOR RETARDER 5/8" GYP BOARD TYPE X.

ADHERED SIMULATED STONE / ADHERED THIN BRICK (DASHED). SEE ELEVATIONS. MORTAR BED W/ METAL LATHE (1) LAYER GRADE D EQUIVALENT BUILDING WRAP / PAPER 1/2" EXTERIOR WALL SHEATHING W/ INTEGRAL W.R.B. (GRADE D) (EXP. 1, SEE STRUCT.) R-21 UNFACED BATT INSULATION 2x6 WD. STUDS (SEE STRUCTURAL) POLY VAPOR RETARDER 5/8" GYP BOARD TYPE X.

WE-1 EXTERIOR BEARING WALL - ULI# U356 SIDING (1-HR RATED)

WE-2 EXTERIOR BEARING WALL - ULI# U356 ADHERED STONE / THIN BRICK (1-HR RATED)

WE-1A EXTERIOR BEARING WALL - ULI# U356 MOLD RESISTANT GYPSUM AT INTERIOR

WE-2A EXTERIOR BEARING WALL - ULI# U356 ADHERED STONE / THIN BRICK (1-HR RATED) MOLD RESISTANT GYPSUM BD. AT INTERIOR

WE-1B EXTERIOR BEARING WALL - ULI# U356 SIDING (1-HR RATED)

WE-3 FOUNDATION WALL - IBC # 4-1.1 (TABLE 721.1) (3-HR RATED)

WE-4 FOUNDATION WALL - IBC # 4-1.1 (TABLE 721.1) (3-HR RATED) - TYPICAL

WE-4A FOUNDATION WALL - IBC # 4-1.1 (TABLE 721.1) (3-HR RATED) - SIDING

FLOOR / CEILING TYPES

3/4" FLOOR TOPPING MIXTURE, EXCEPT HARD SURFACES. USE 1/4" SOUND MAT AND 3/4" MIN. TOPPING DEPTH (SEE STRUCTURAL). 3/4" T&G FLOOR SHEATHING (SEE STRUCTURAL). PLATED WOOD TRUSSES (SEE STRUCTURAL). FILL TRUSS FULL W/ BLOWN FIBERGLASS INSULATION. 1/2" RESILIENT CHANNELS @ 12" O.C. VERIFY W/ GYPSUM BOARD MANUF. 5/8" TYPE C GYPSUM BOARD (SUSPENDED ACT WHERE OCCURS. SEE CEILING PLANS - DASHED).

3/4" FLOOR TOPPING MIXTURE. EXCEPT HARD SURFACES. USE 1/4" SOUND MAT AND 3/4" MIN. TOPPING DEPTH (SEE STRUCTURAL). 3/4" T&G FLOOR SHEATHING (SEE STRUCTURAL). WOOD FLOOR JOISTS (SEE STRUCTURAL). FILL JOIST SPACE FULL W/ UNFACED FIBERGLASS BATT INSULATION. 1/2" RESILIENT CHANNELS @ 12" O.C. VERIFY W/ GYPSUM BOARD MANUF. 5/8" TYPE C GYPSUM BOARD (SUSPENDED ACT WHERE OCCURS. SEE CEILING PLANS - DASHED).

FC-1 FLOOR / CEILING ASSEMBLY ULI# L558 GA FILE # FC 5514

FC-2 FLOOR / CEILING ASSEMBLY ULI# L501 GA FILE # FC 5428

FC-3 FLOOR / CEILING ASSEMBLY ULI# J919

FC-4 FLOOR / CEILING ASSEMBLY ULI# J919

FC-5 FLOOR ASSEMBLY - SLAB

FC-6 FLOOR / CEILING ASSEMBLY

4" CONCRETE FLOOR POLY VAPOR BARRIER 6" GRANULAR FILL

3/4" T&G FLOOR SHEATHING (SEE STRUCTURAL) WOOD FLOOR JOISTS (SEE STRUCTURAL)

ROOF / CEILING TYPES

SHINGLES ROOFING UNDERLAYMENT 1/2" EXTERIOR PLYWOOD ROOF SHEATHING (SEE STRUCTURAL). ENGINEERED ROOF TRUSSES (SEE STRUCTURAL). R-40 MIN. LOOSE FILL FIBERGLASS INSULATION. 1/2" RESILIENT CHANNELS. VERIFY SPACING W/ GYPSUM MANUFACTURER. 5/8" TYPE C GYPSUM BOARD.

SHINGLES ROOFING UNDERLAYMENT 1/2" EXTERIOR PLYWOOD ROOF SHEATHING (SEE STRUCTURAL). ROOF JOISTS (SEE STRUCTURAL). 2X10 WOOD FLOORING. R-40 MIN. FIBERGLASS BATT INSULATION. POLY VAPOR RETARDER (2) LAYERS 5/8" TYPE X GYPSUM BOARD.

RC-1 ROOF / CEILING ASSEMBLY ULI# P533 GA FILE # RC 2803

RC-2 ROOF / CEILING ASSEMBLY IBC # 21-1.1 (TABLE 721.1)

RC-3 ROOF / CEILING ASSEMBLY AER-09038

1" LINER PANEL 18 GAUGE 4" C.H. STUDS @ 24" O.C. (2) LAYERS 5/8" FIRE CODE GYP. BD. TYPE C

- ### KEYNOTES - WALL SECTIONS
- R-21 UNFACED FIBERGLASS BATT INSULATION CLIPPED IN TRUSS @ ATTIC SIDE OF SHAFT WALL
 - HOIST BEAM. SEE STRUCT.
 - SEAL PENETRATION AT ROOF / WALL ASSEMBLY
 - ELEVATOR PIT LADDER IN BACKGROUNDS. COORDINATE W/ ELEVATOR MANUFACTURER
 - DRAIN TILE IN GRAVEL BED. VERIFY W/ PLUMBING FOR CONNECTION & SIZE. TILE PIPING INTO STORM SYSTEM
 - INFILL FLOOR FRAMING. SEE STRUCTURAL FOR ADDITIONAL INFORMATION
 - FILL PRECAST CORES W/ CONCRETE
 - POLY VAPOR RETARDER INSIDE SHAFT KEEP ON WARM SIDE OF WALL/CEILING
 - CONCRETE FOUNDATION WALL AT ELEVATOR PIT. SEE STRUCT.
 - CONCRETE FOOTING/ELEVATOR PIT BOTTOM. SEE STRUCT.
 - TRASH CHUTE FLASHING. TIE INTO ROOF SYSTEM COORDINATE W/ MANUFACTURER
 - WATER PROOFING. SEE SPECIFICATION (SHOWN DASHED)
 - INFILL FLOOR FRAMING (SHOWN DASHED). COORDINATE WITH TRASH CHUTE MANUFACTURER FOR INSTALLATION BEYOND ROOF TRUSS BEARING
 - TRASH CHUTE - PROVIDE FIRE RATING AT ALL PENETRATIONS

GENERAL NOTES:

1. SEE PARKING LEVEL PLANS FOR INTERIOR WALL TYPES AT THE PARKING LEVEL AREAS. SEE ENLARGED UNIT PLANS FOR INTERIOR WALL TYPES AT STORIES ABOVE THE PARKING LEVEL.



I hereby certify that this plan, specification or report was prepared by me or under my direct supervision & that I am a duly Licensed Architect under the laws of the State of Minnesota

Signature:

Printed Name: Tim Gillet
License No.: 51031
Date: 02/19/2021

These drawings and specifications are the sole property of HMA Architects, Ltd. any reproduction or reuse of these documents is forbidden without written permission from HMA Architects, Ltd.

Project No: 2037
Project Manager: DAS
Drawn By: NJT
Date: 02/19/2021

Date	Description
03/08/2021	Addendum 2



700 W. St. Germain Street
Suite 200
St. Cloud, MN 56301
www.hma-archs.com

T | 320.251.9155
F | 320.251.4919
hma@hma-archs.com


New Apartment Complex:

Zumbrota
Apartment
Complex


Zumbrota, MN

WALL SECTIONS

A501

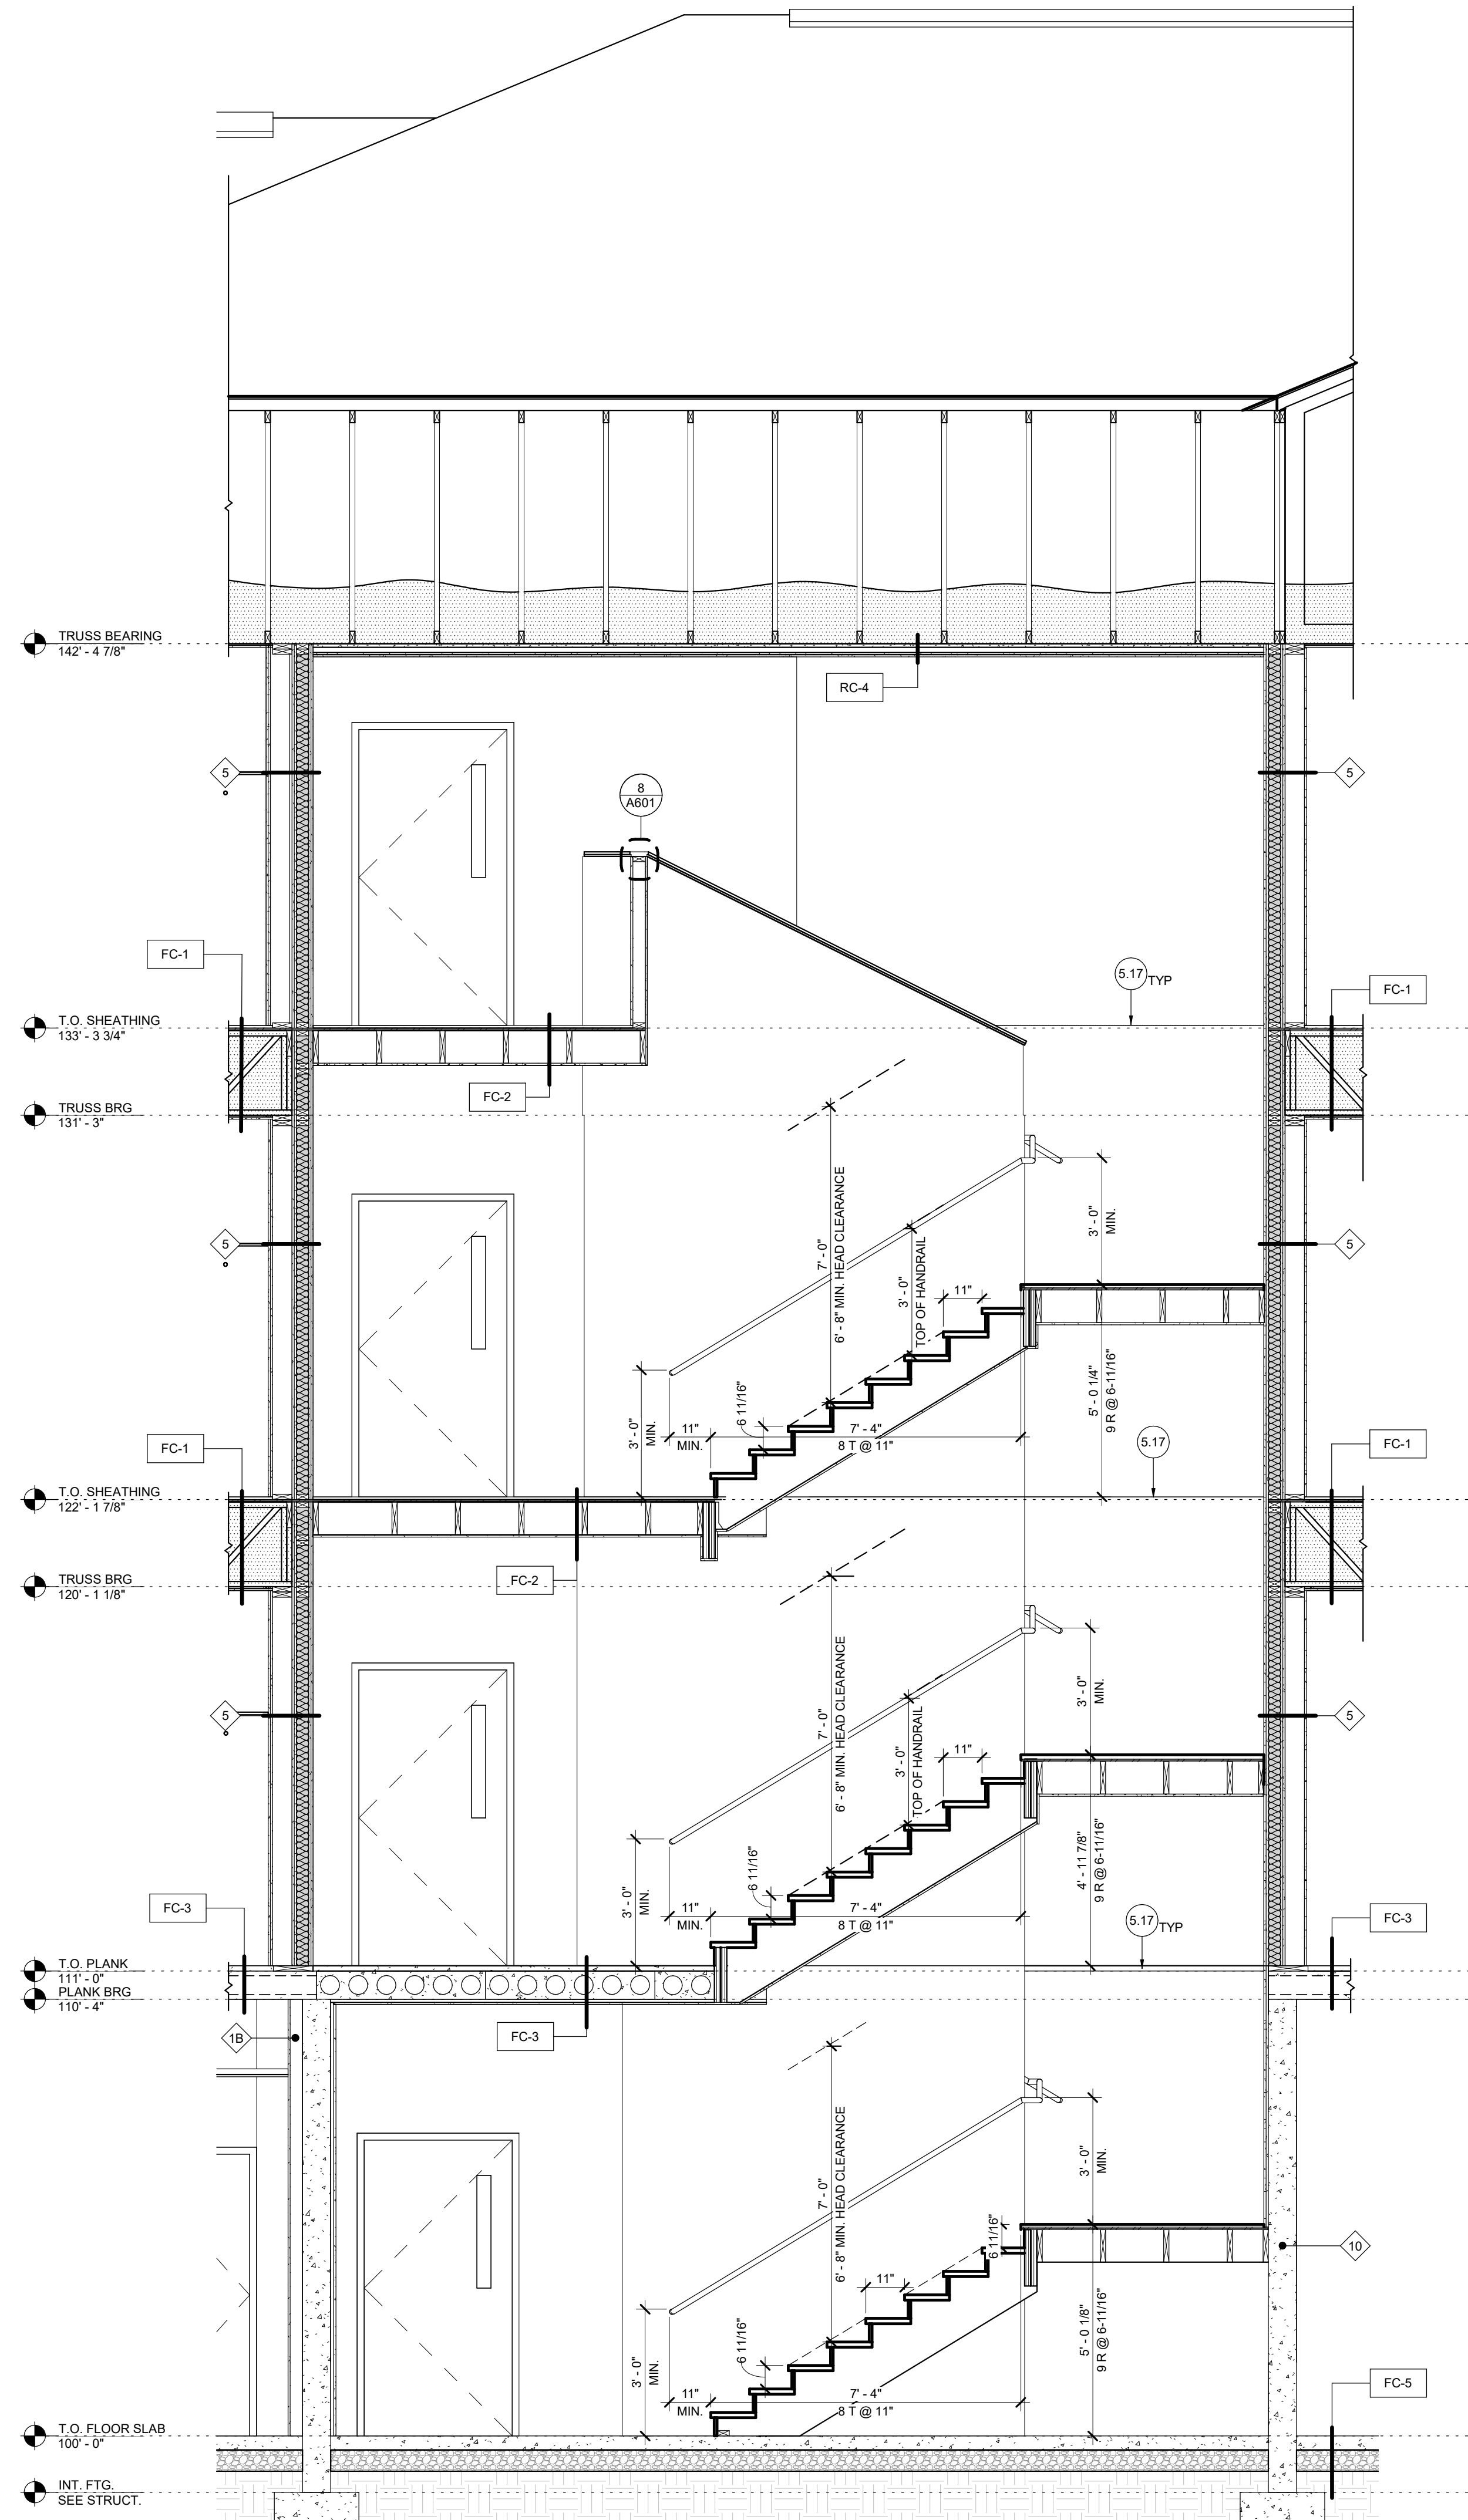


1 STAIR 'B' - SECTION
A503 SCALE: 3/8" = 1'-0"

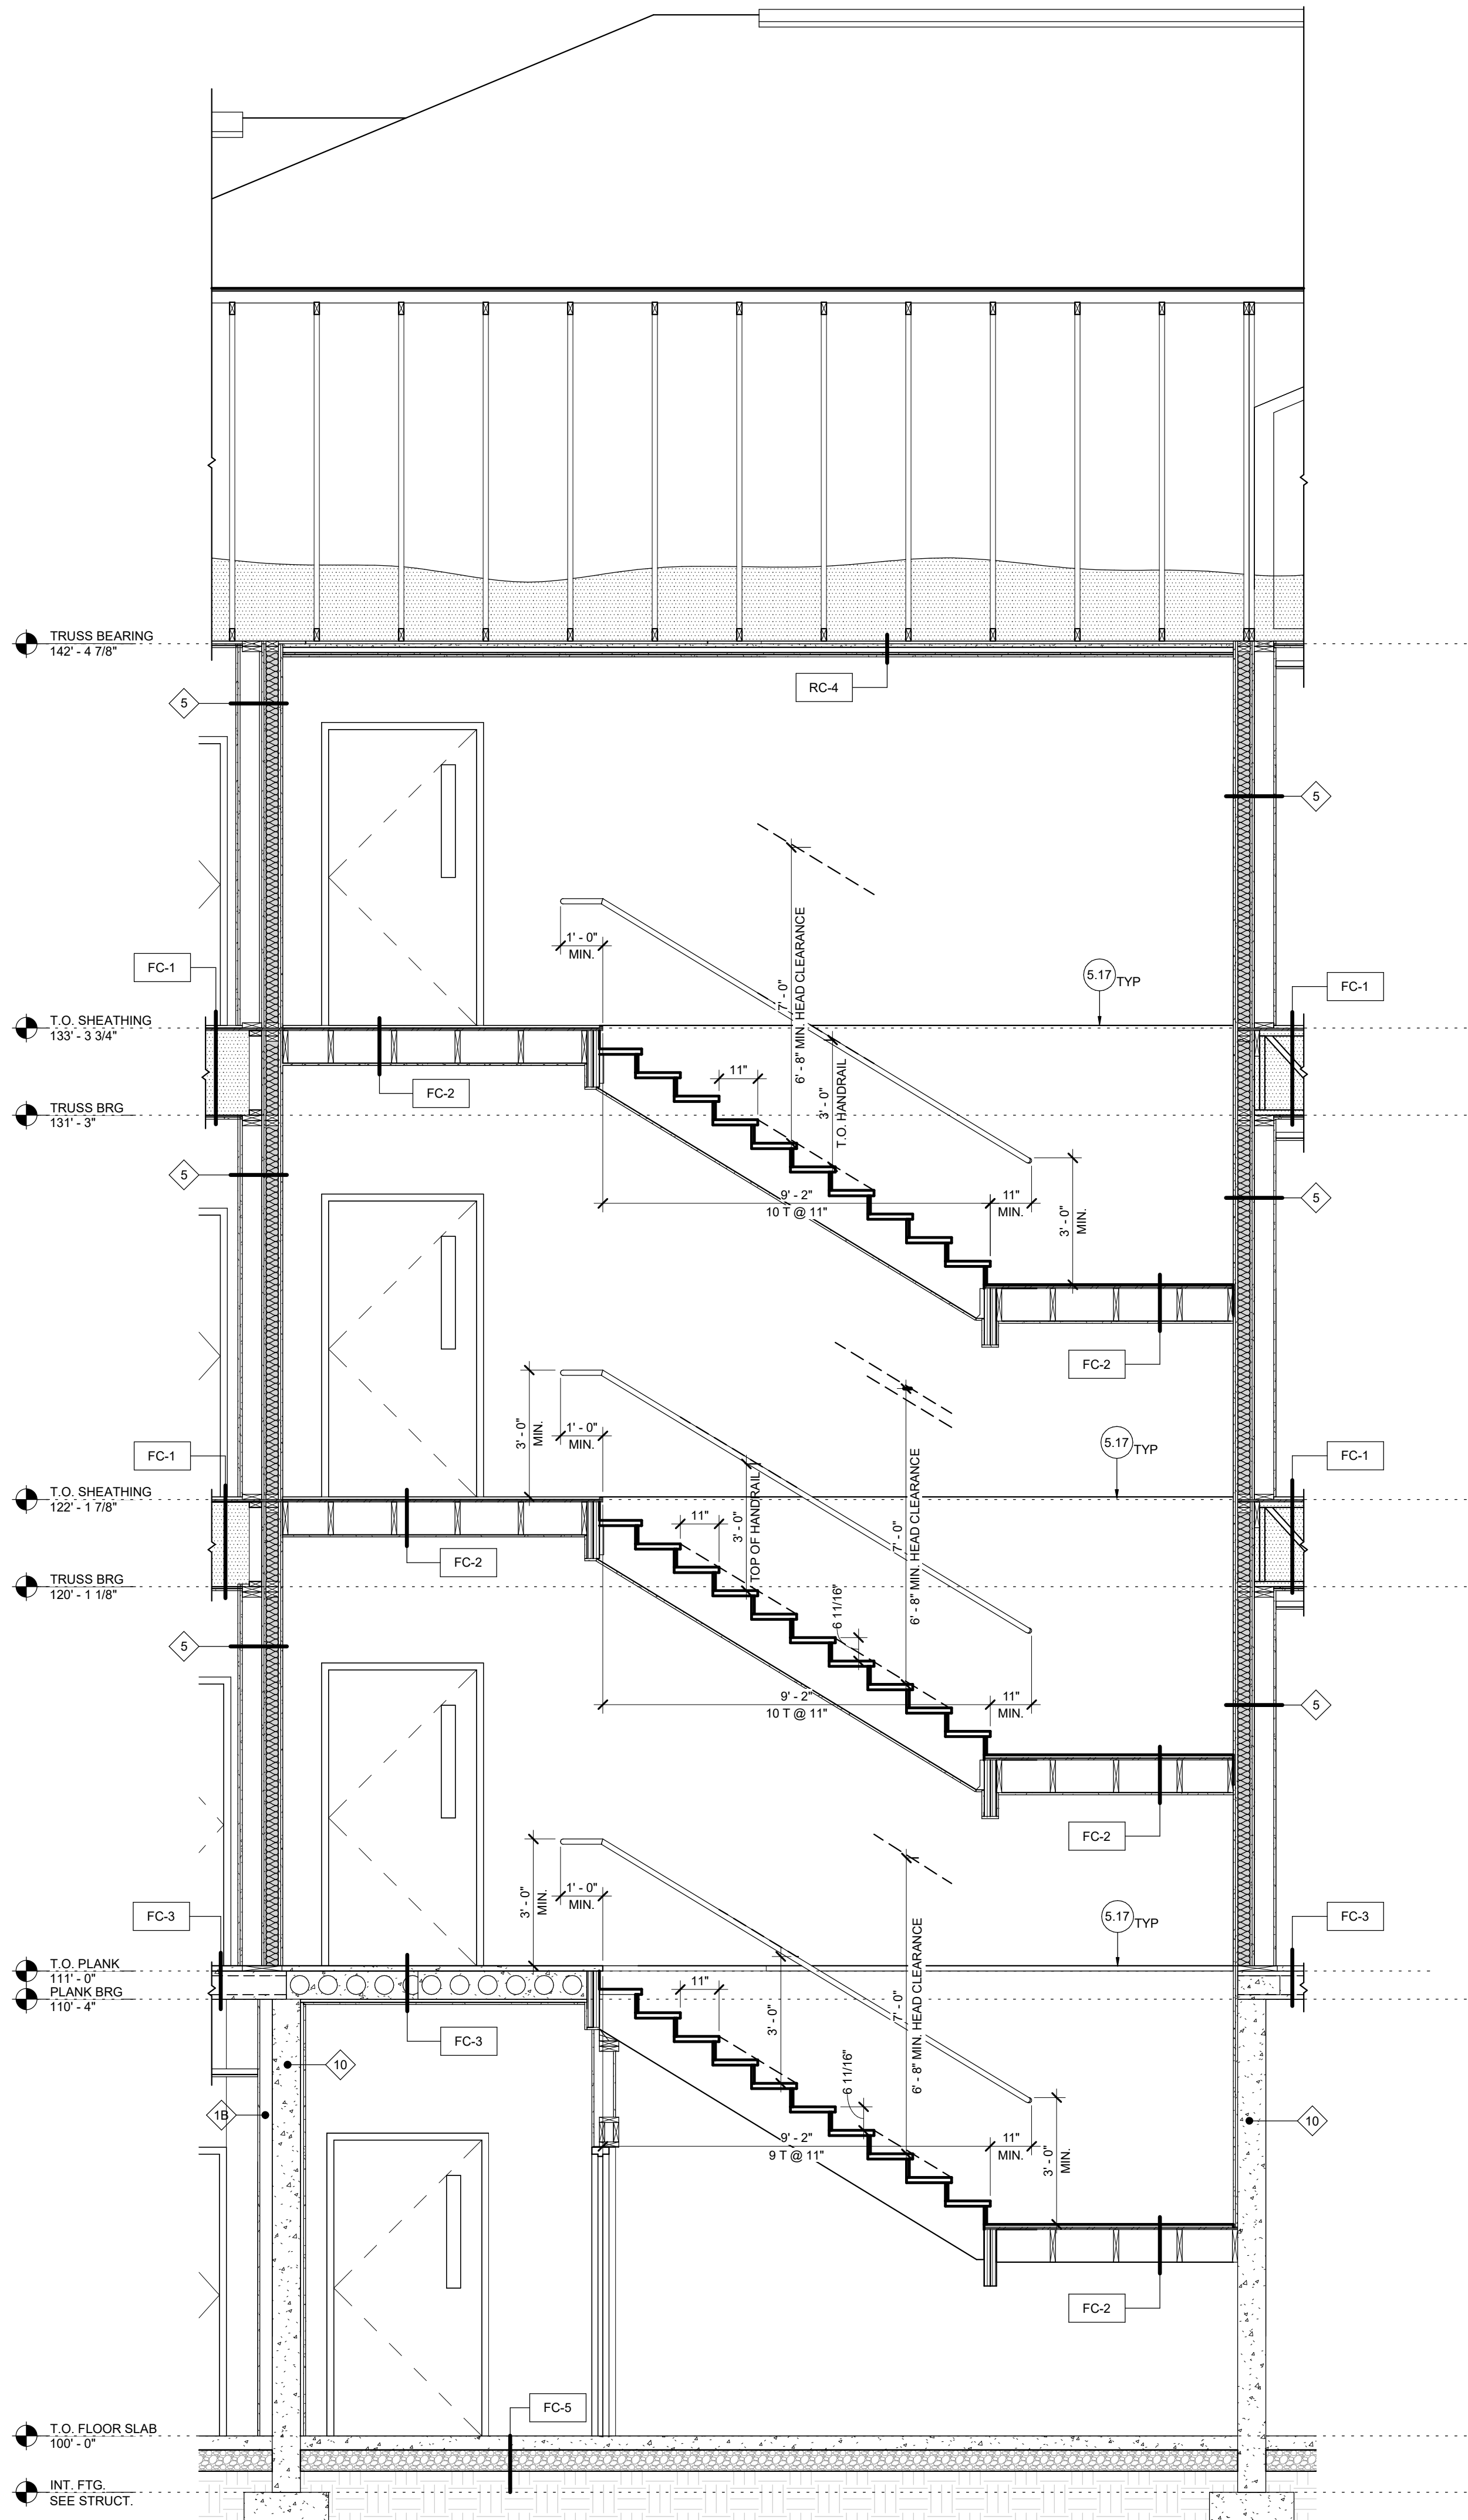


2 STAIR 'B' - SECTION
A503 SCALE: 3/8" = 1'-0"


EXTERIOR WALL TYPES

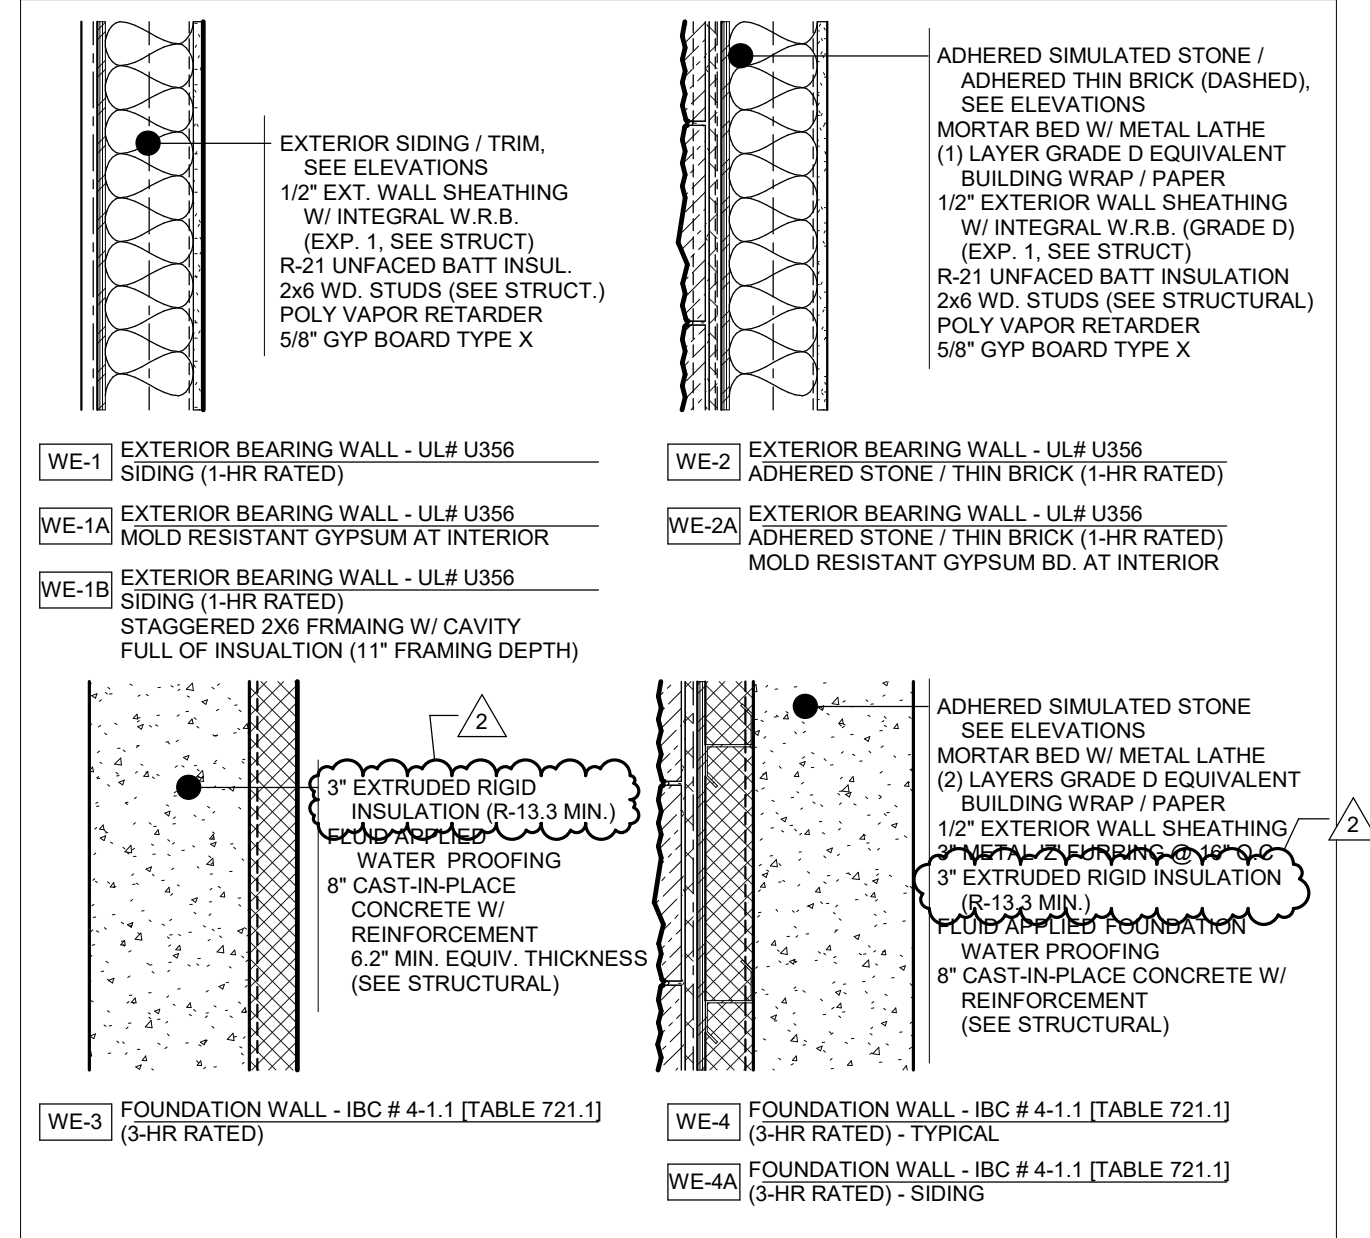

FLOOR / CEILING TYPES

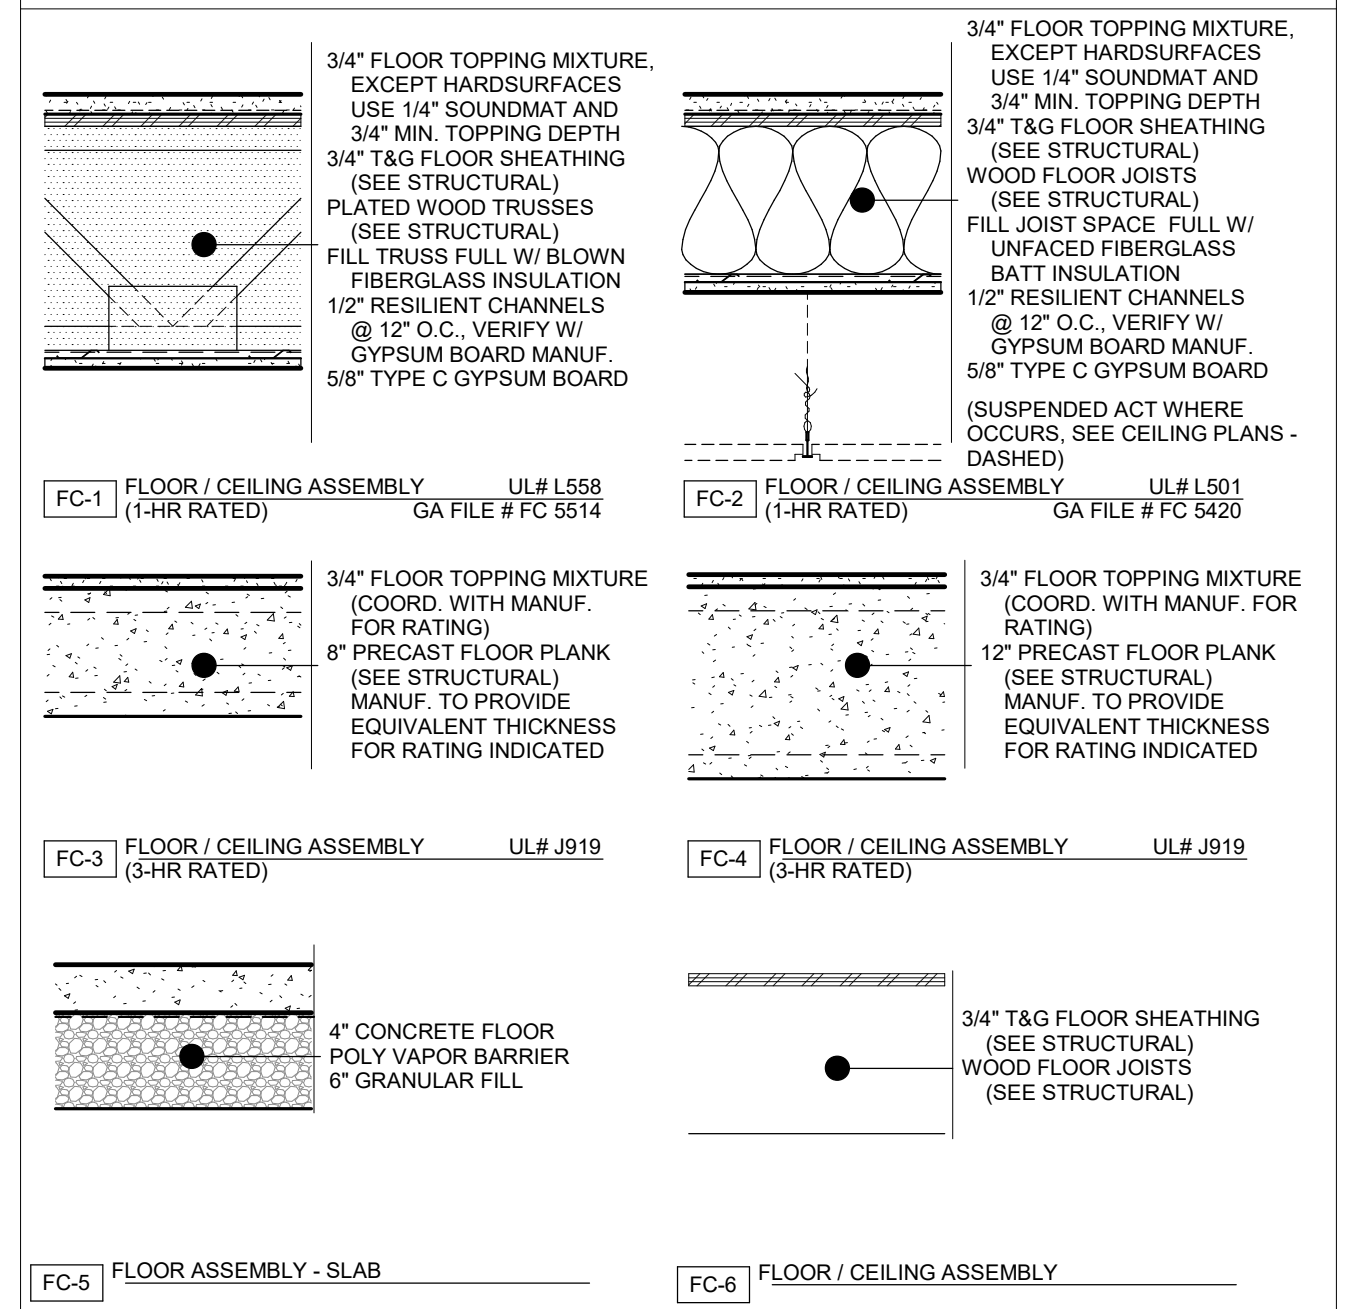

ROOF / CEILING TYPES

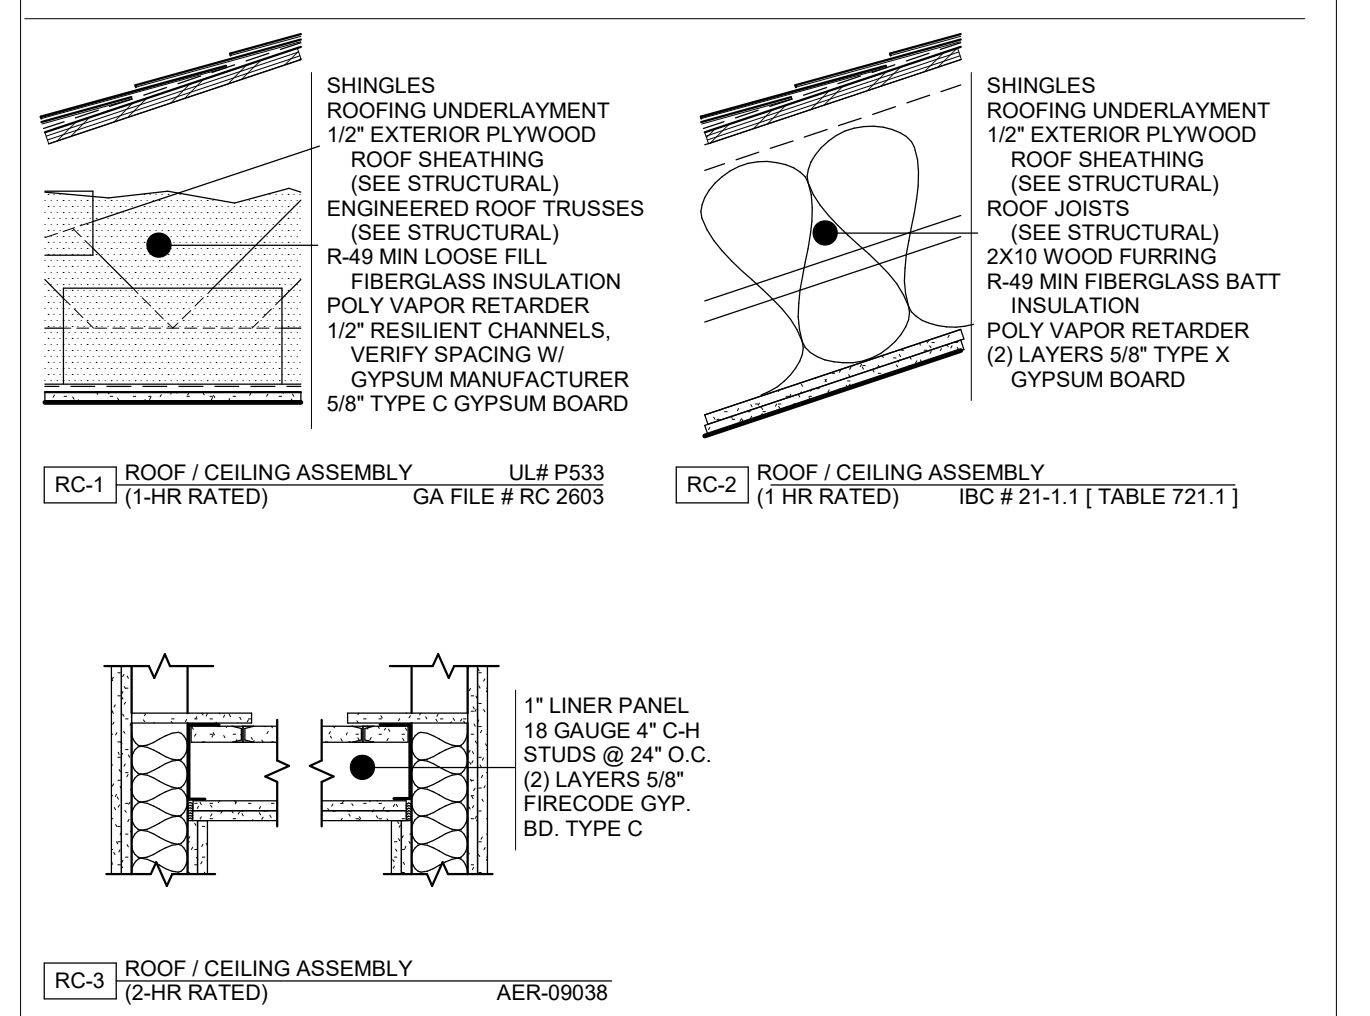

KEYNOTES - WALL SECTIONS

5.17 CONTROL JOINT, TYP.



I hereby certify that this plan, specification or report was prepared by me or under my direct supervision & that I am a duly Licensed Architect under the laws of the State of Minnesota
 Signature: _____
 Printed Name: Tim Gillet
 License No.: 51031
 Date: 02/19/2021

These drawings and specifications are the sole property of HMA Architects, Ltd. any reproduction or reuse of these documents is forbidden without written permission from HMA Architects, Ltd.

Project No: 2037
 Project Manager: DAS
 Drawn By: NJT
 Date: 02/19/2021

Date	Description
03/09/2021	Addendum 2



700 W. St. Germain Street
 Suite 200
 St. Cloud, MN 56301
 www.hma-archs.com

T | 320.251.9155
 F | 320.251.4919
 hma@hma-archs.com


New Apartment Complex:

Zumbrota
 Apartment
 Complex


Zumbrota, MN

WALL SECTIONS


A503

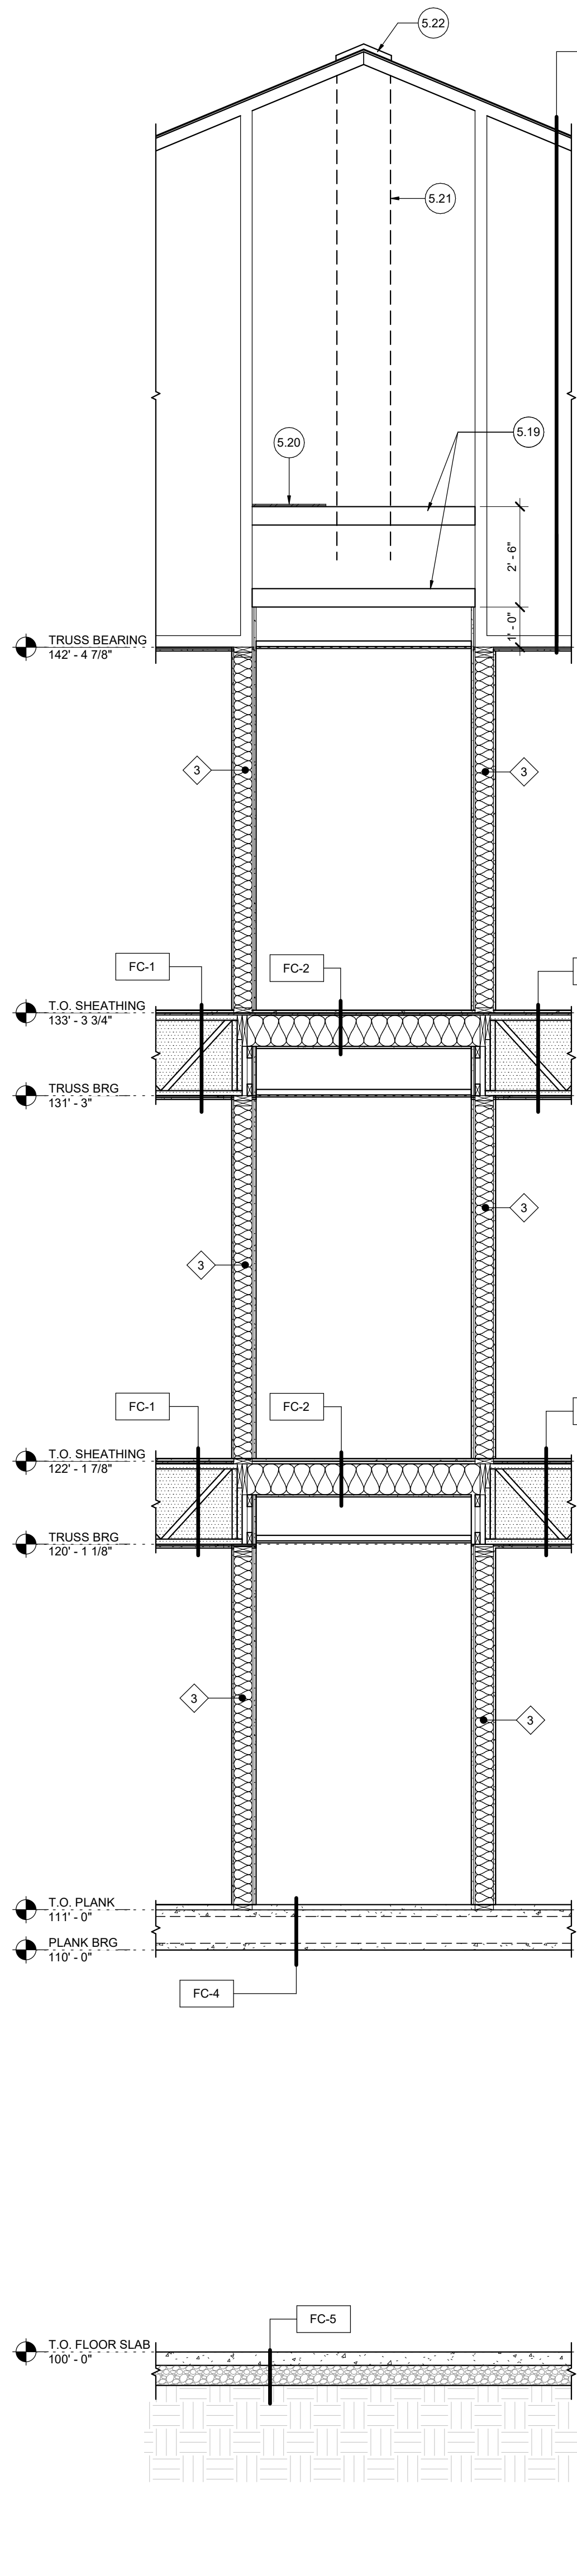


1 WALL SECTION
A505 SCALE: 3/8" = 1'-0"

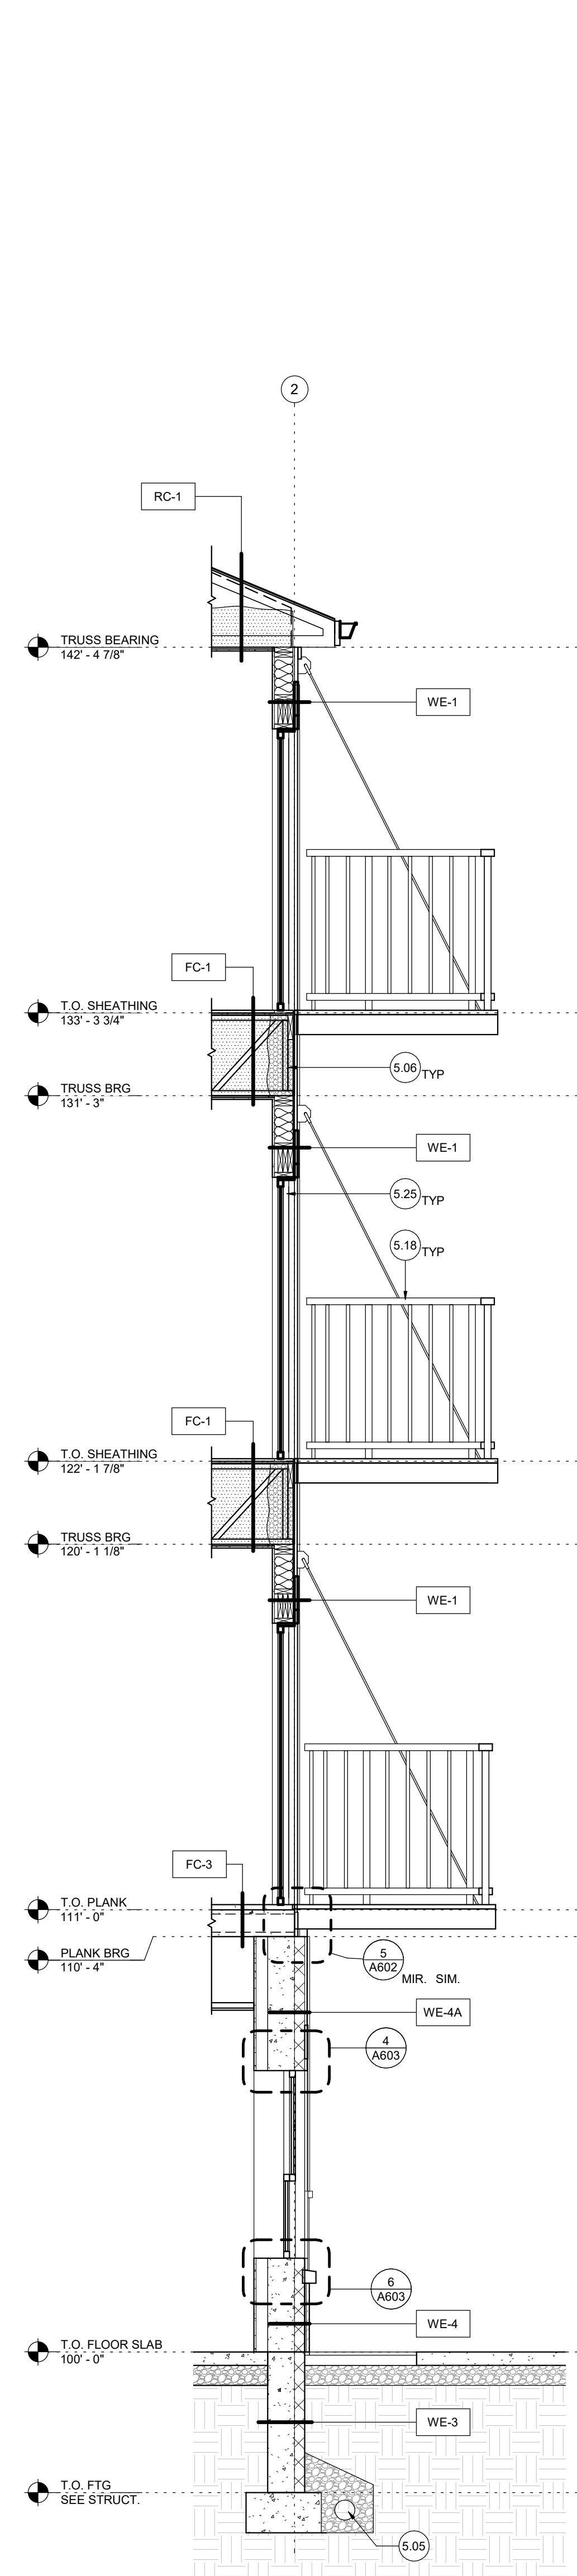

2 WALL SECTION
A505 SCALE: 3/8" = 1'-0"

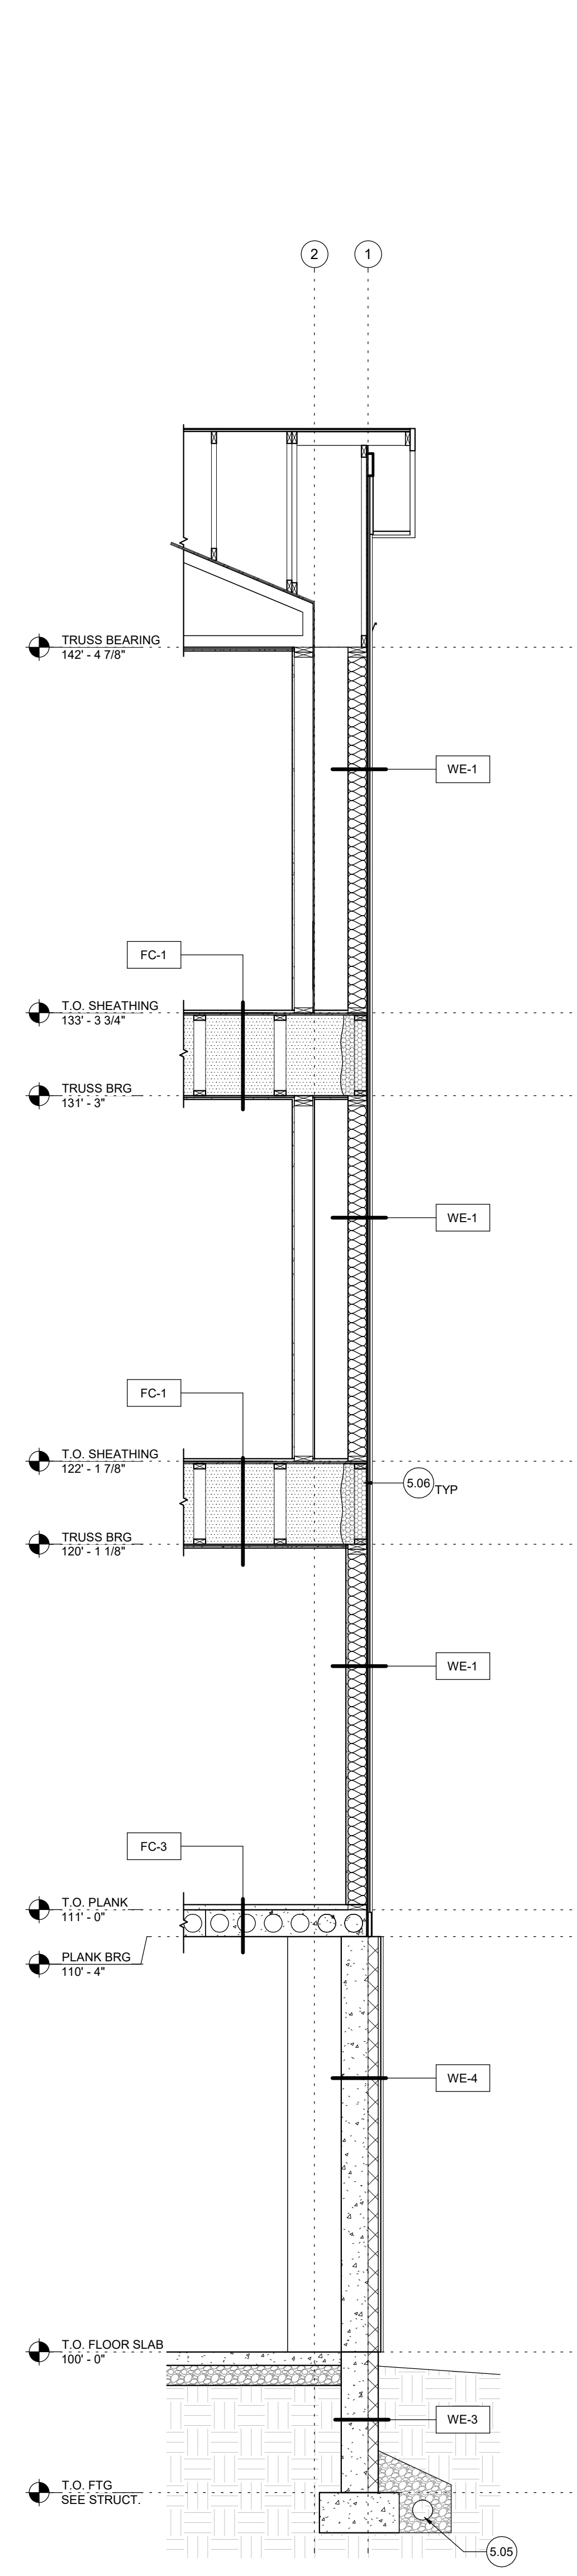


3 WALL SECTION
A505 SCALE: 3/8" = 1'-0"

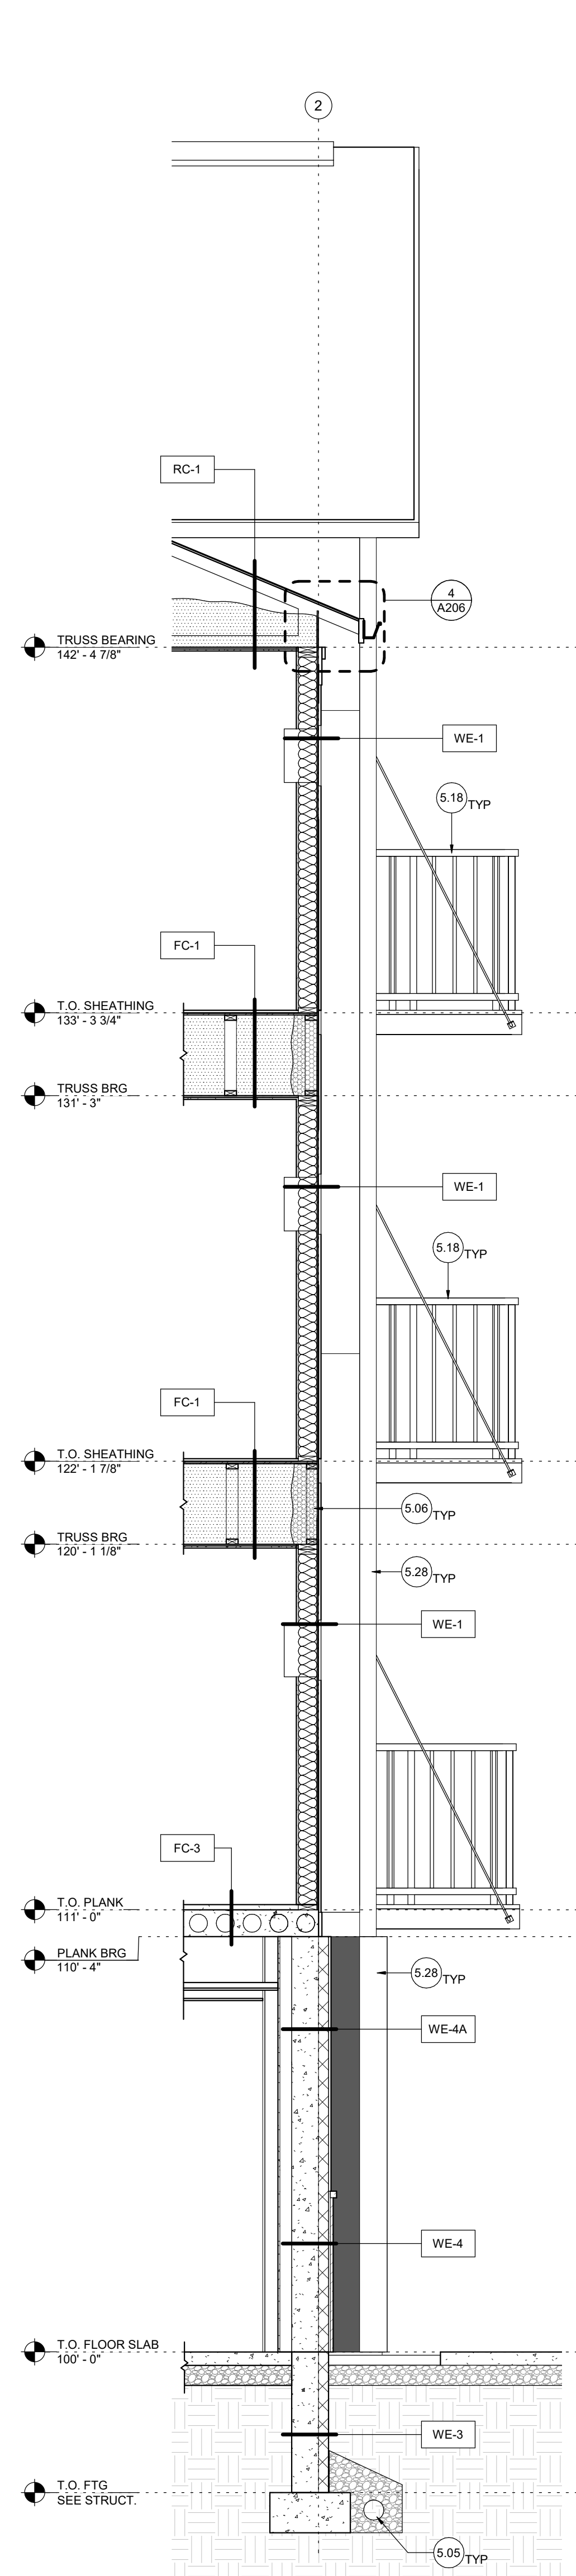


4 WALL SECTION
A505 SCALE: 3/8" = 1'-0"


EXTERIOR WALL TYPES

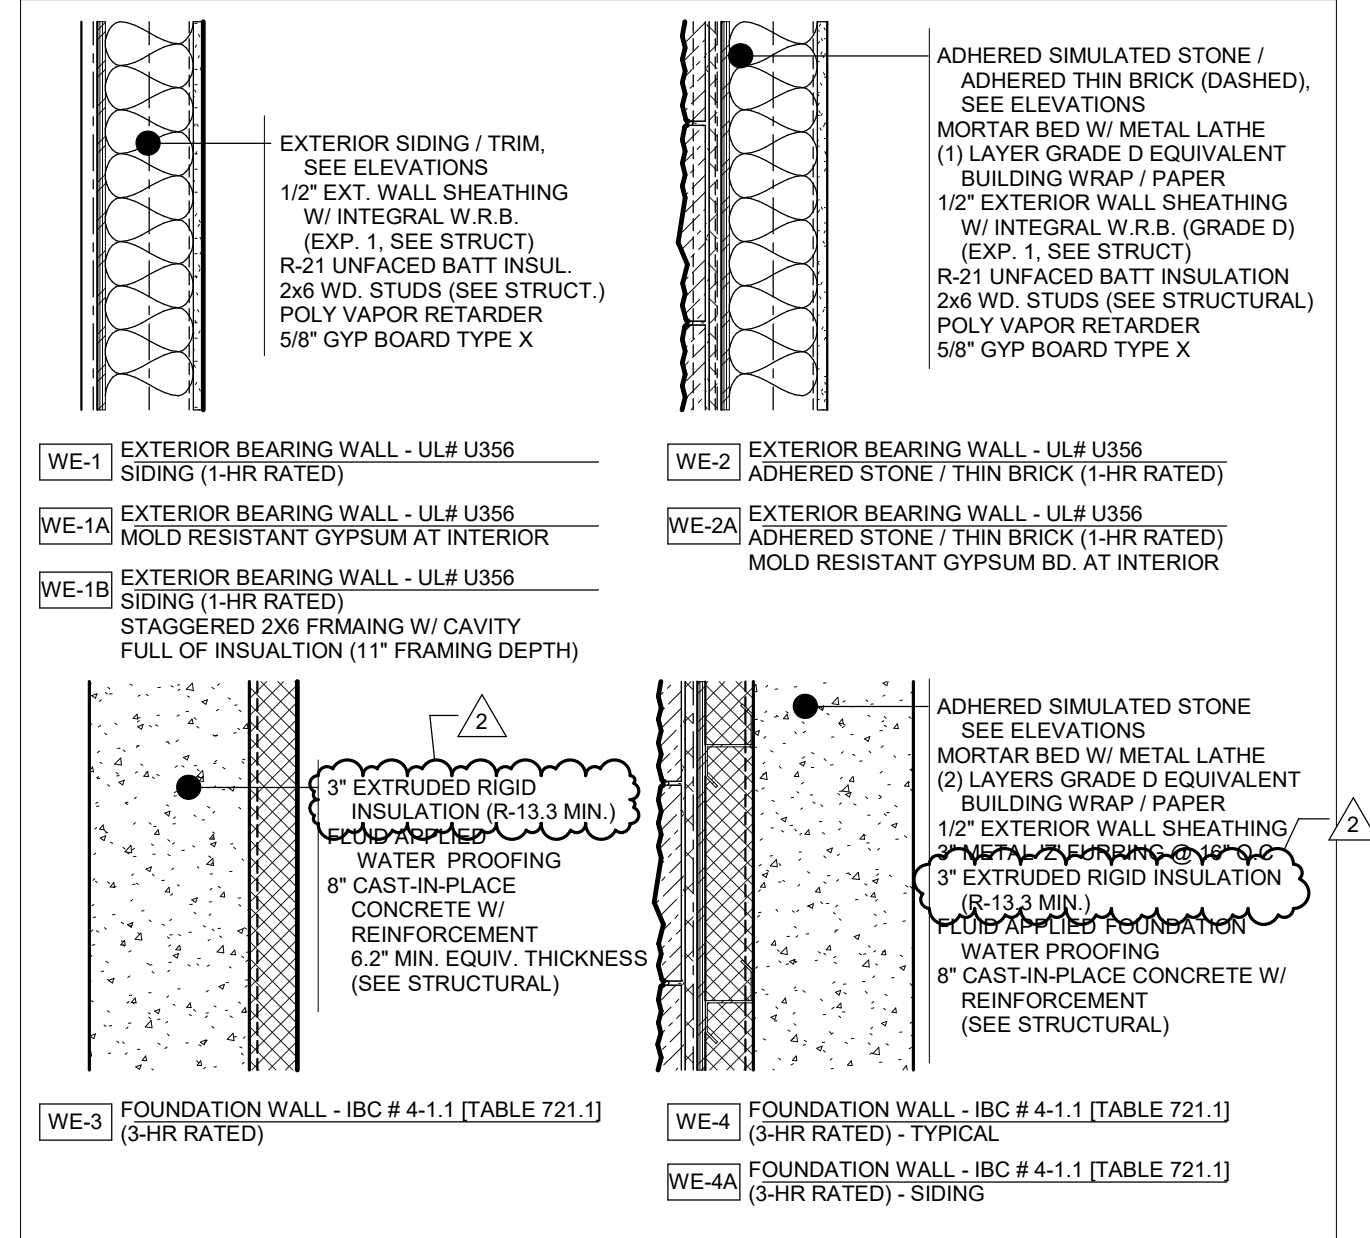

FLOOR / CEILING TYPES

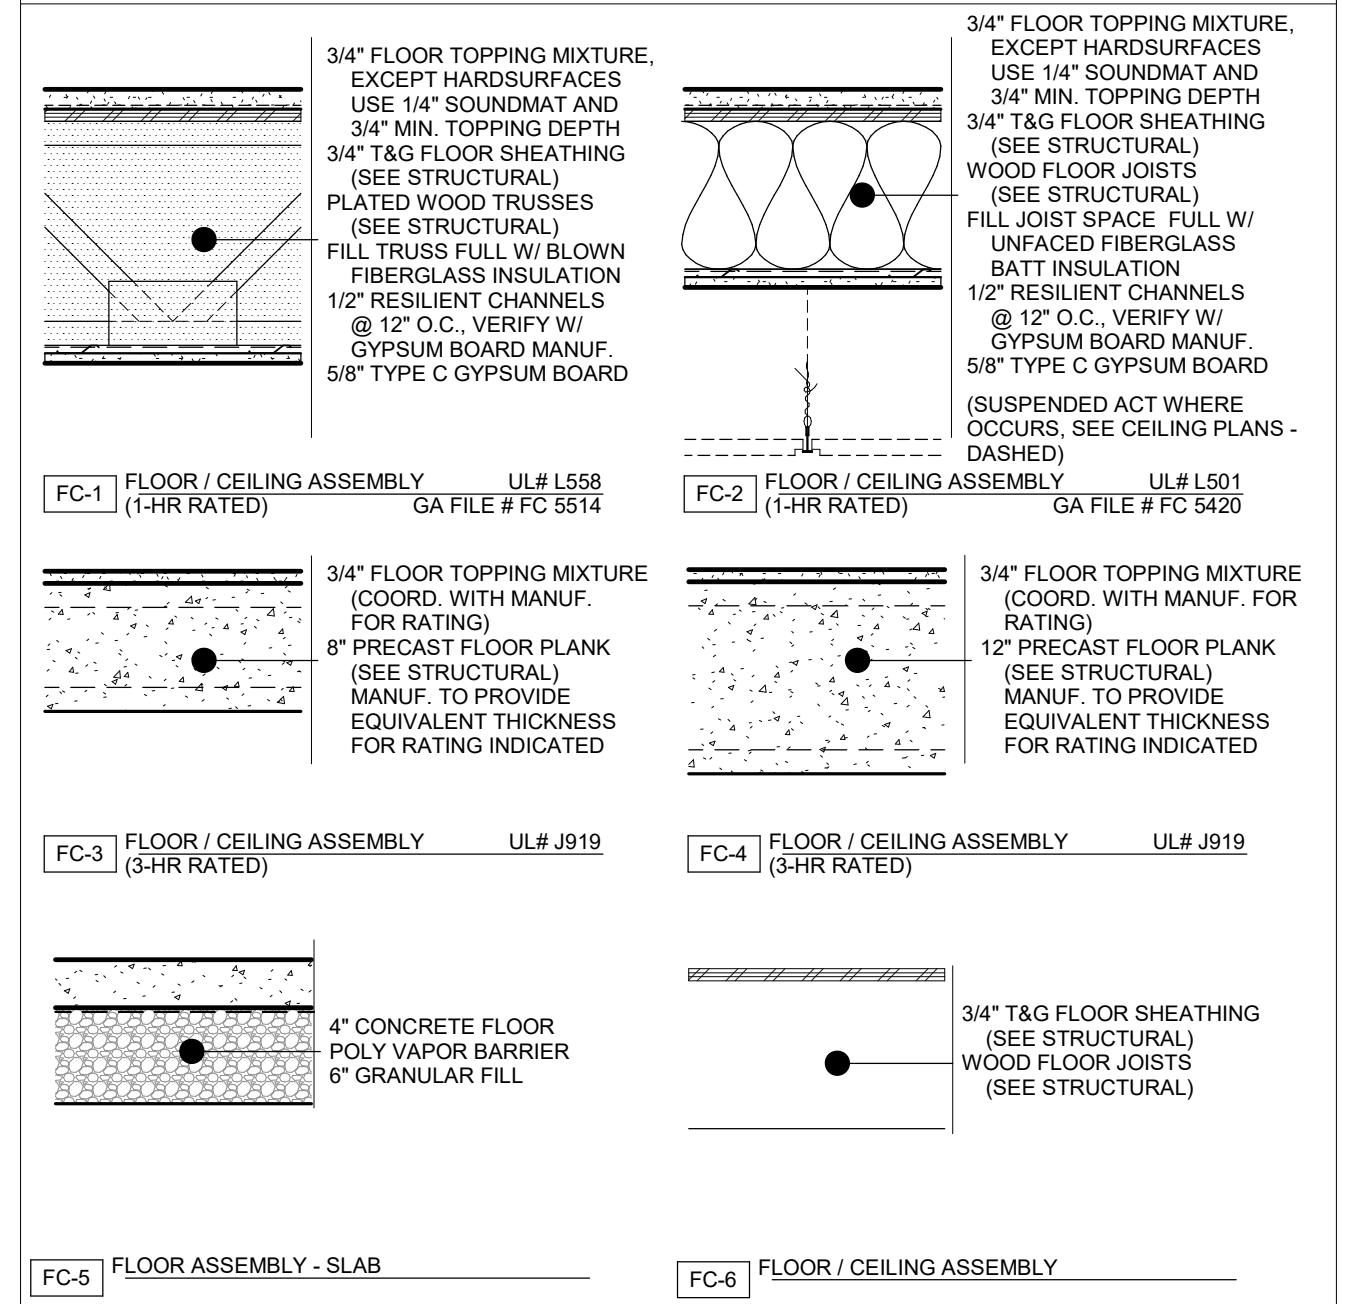

ROOF / CEILING TYPES

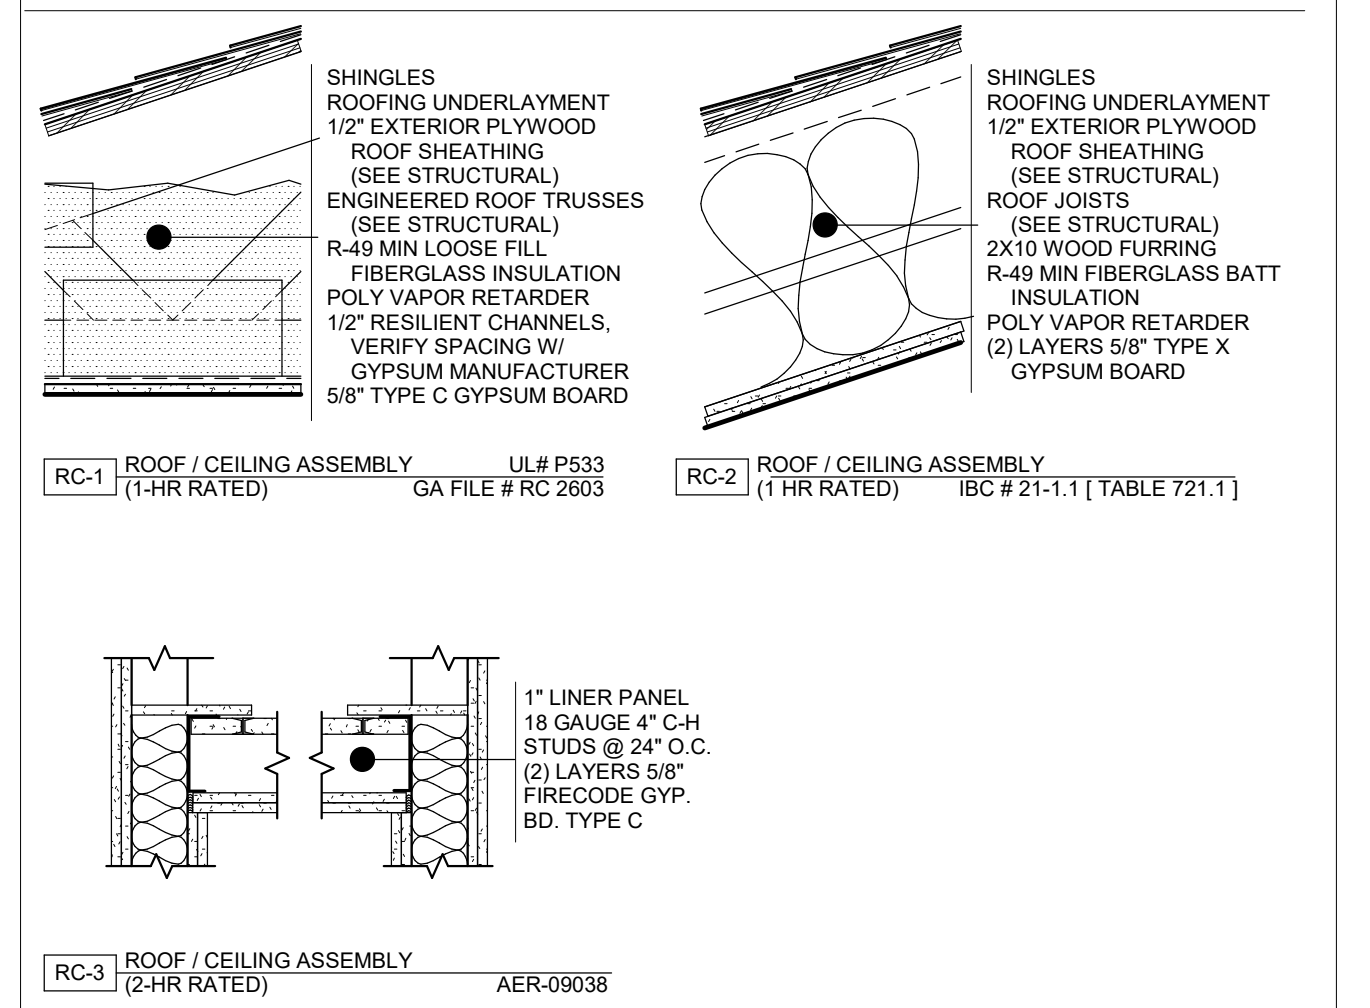

KEYNOTES - WALL SECTIONS

- 5.05 DRAIN TILE IN GRAVEL BED. VERIFY W/ PLUMBING FOR CONNECTION & SIZE. TILE PIPING INTO STORM SYSTEM.
- 5.06 SPRAY FOAM INSULATION AS REQUIRED (R-21 MIN.)
- 5.18 PREF-FRG ALUMINUM BALCONY, BY OTHERS
- 5.19 2X6 FRAMING @ 2'-0" O.C.
- 5.20 3/4" PLYWOOD ATTC ACCESS WALKWAY COORD. WITH ROOF TRUSSES & ROOF PLAN
- 5.21 KEEP CENTER OPEN FOR SPRINKLER PIPING. COORDINATE W/ FIRE PROTECTION CONTACTOR
- 5.22 CONTINUOUS RIDGE VENT
- 5.25 VINYL PATIO DOOR OPENING AS SCHEDULED
- 5.26 LP CORNER TRIM



I hereby certify that this plan, specification or report was prepared by me or under my direct supervision & that I am a duly Licensed Architect under the laws of the State of Minnesota

Signature:

Printed Name: Tim Gillet
License No.: 51031
Date: 02/19/2021

These drawings and specifications are the sole property of HMA Architects, Ltd. any reproduction or reuse of these documents is forbidden without written permission from HMA Architects, Ltd.

Project No: 2037
Project Manager: DAS
Drawn By: NJT
Date: 02/19/2021

Date	Description
2	03/08/2021 Addendum 2



700 W. St. Germain Street
Suite 200
St. Cloud, MN 56301
www.hma-archs.com

T | 320.251.9155
F | 320.251.4919
hma@hma-archs.com


New Apartment Complex:

Zumbrota
Apartment
Complex

Zumbrota, MN

WALL SECTIONS

A505

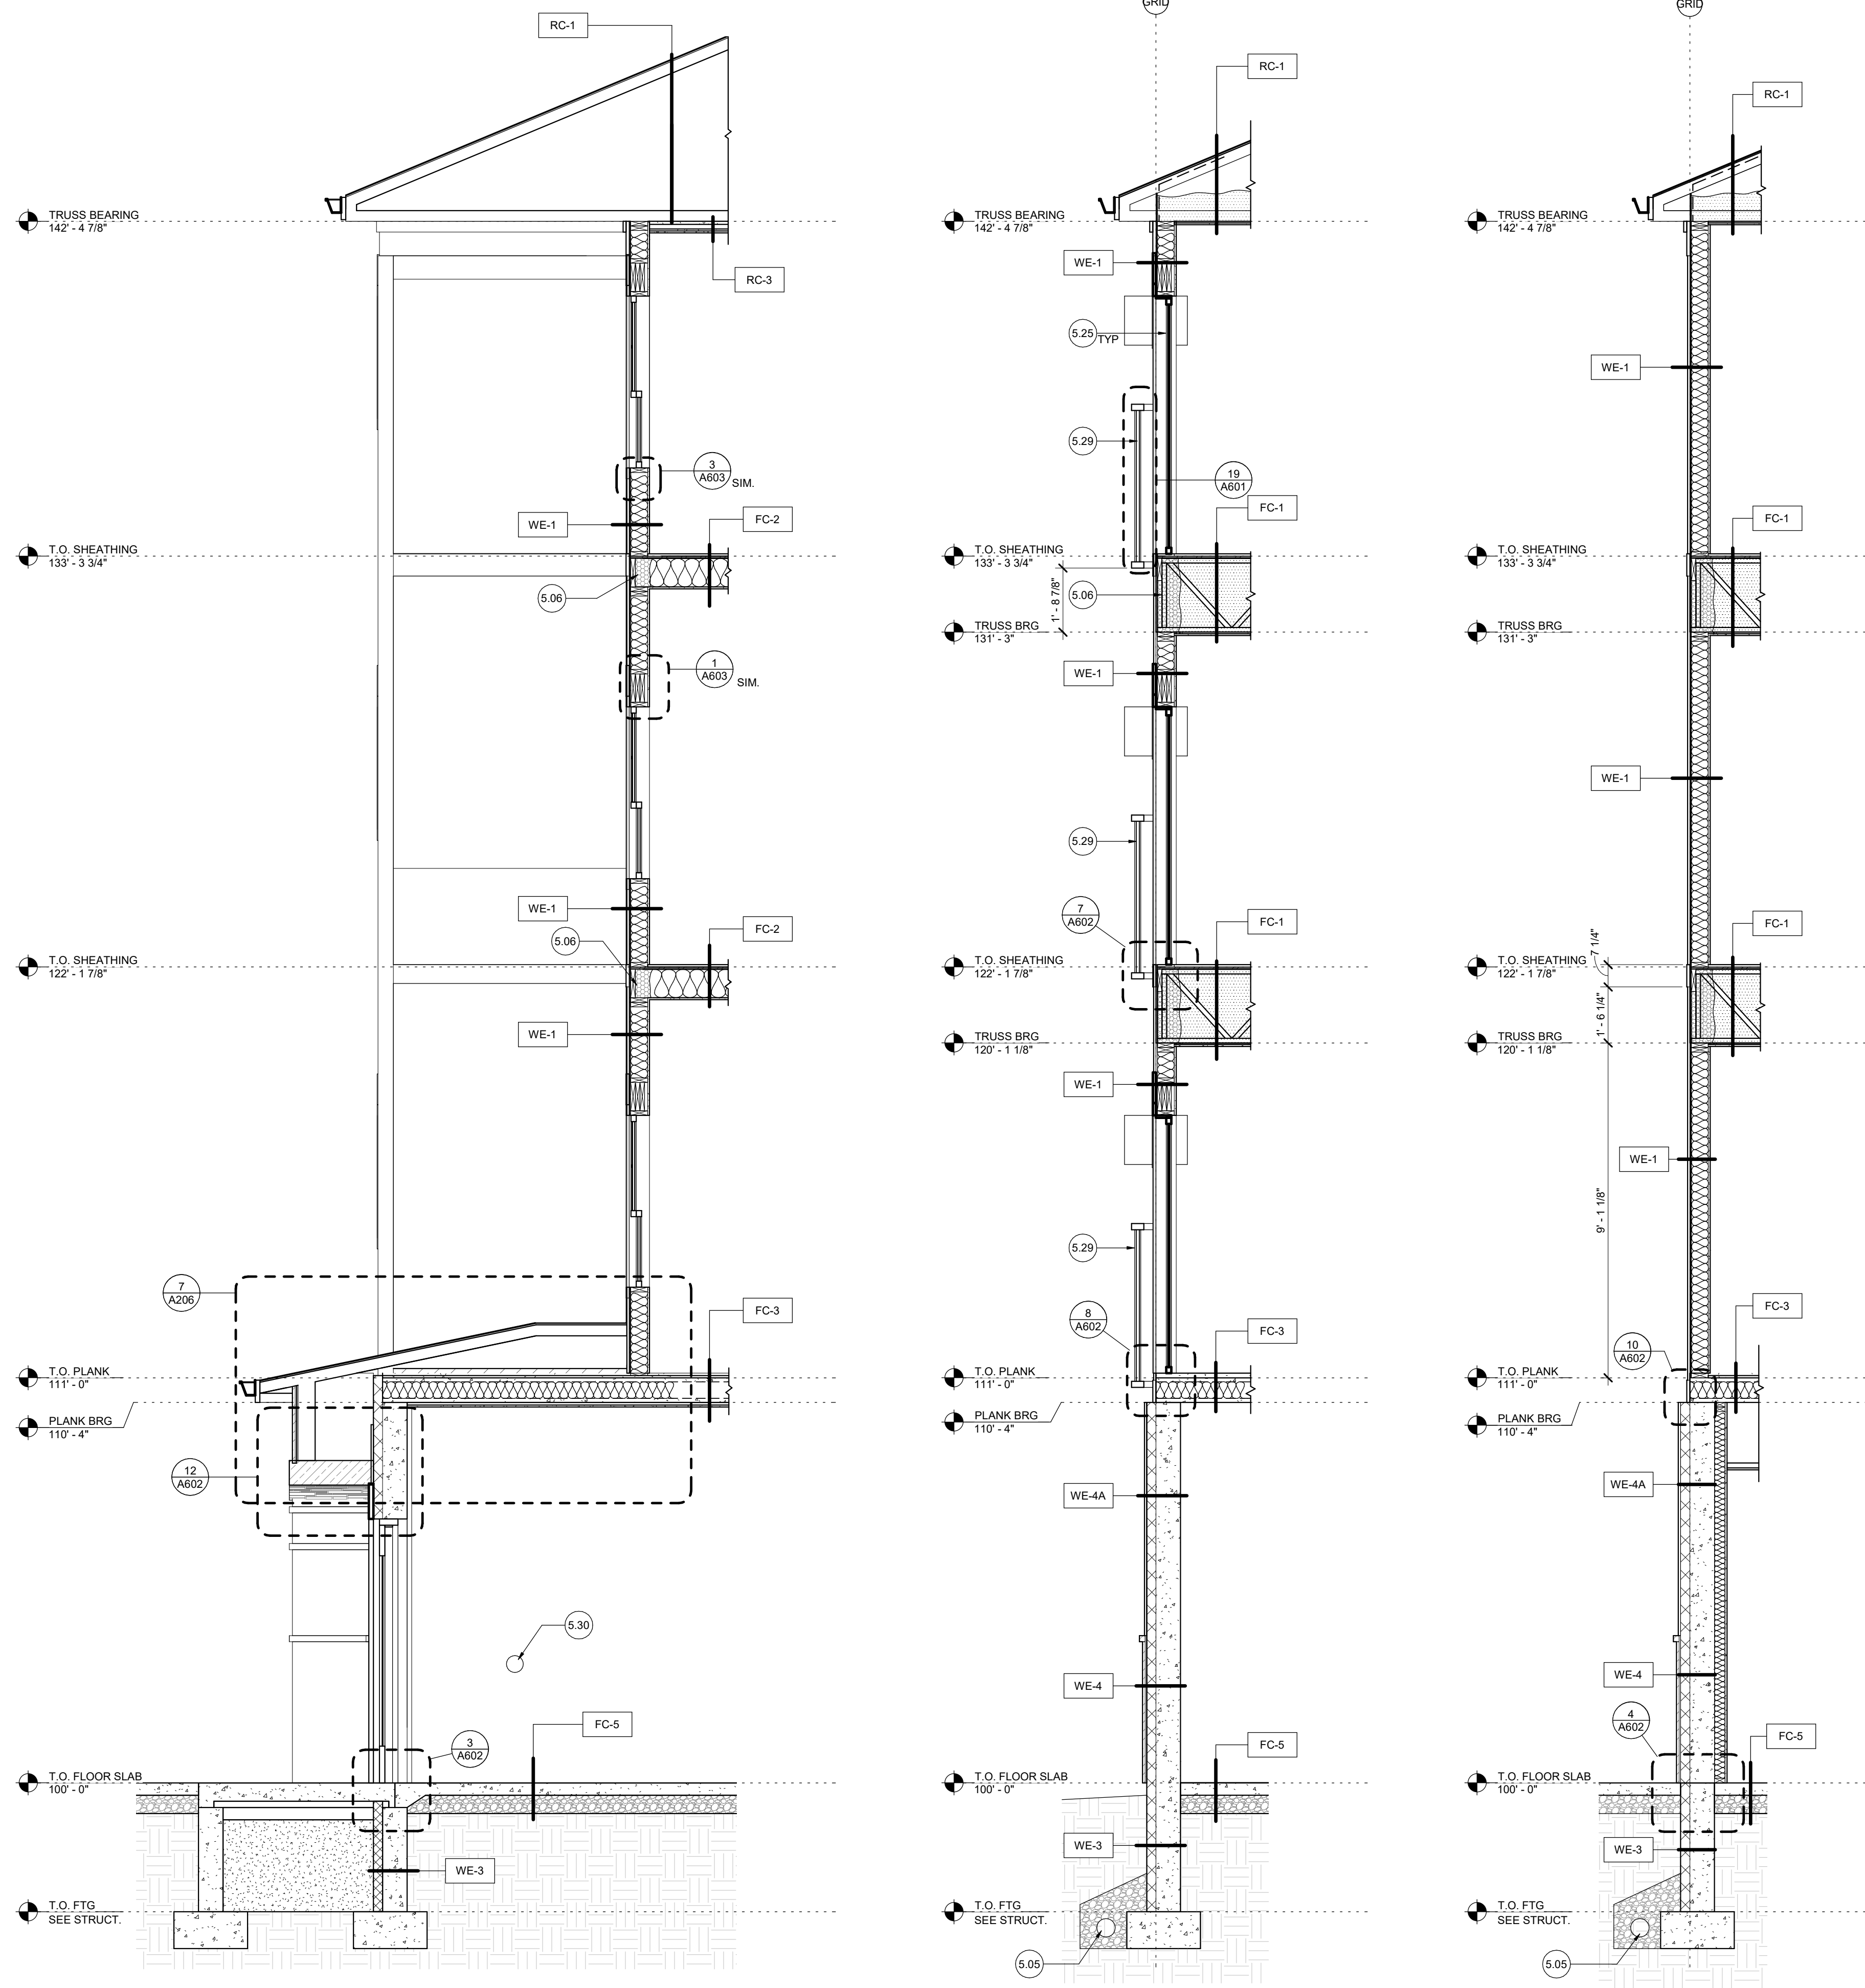


1 WALL SECTION
SCALE: 3/8" = 1'-0"


2 WALL SECTION
SCALE: 3/8" = 1'-0"

3 WALL SECTION
SCALE: 3/8" = 1'-0"


EXTERIOR WALL TYPES

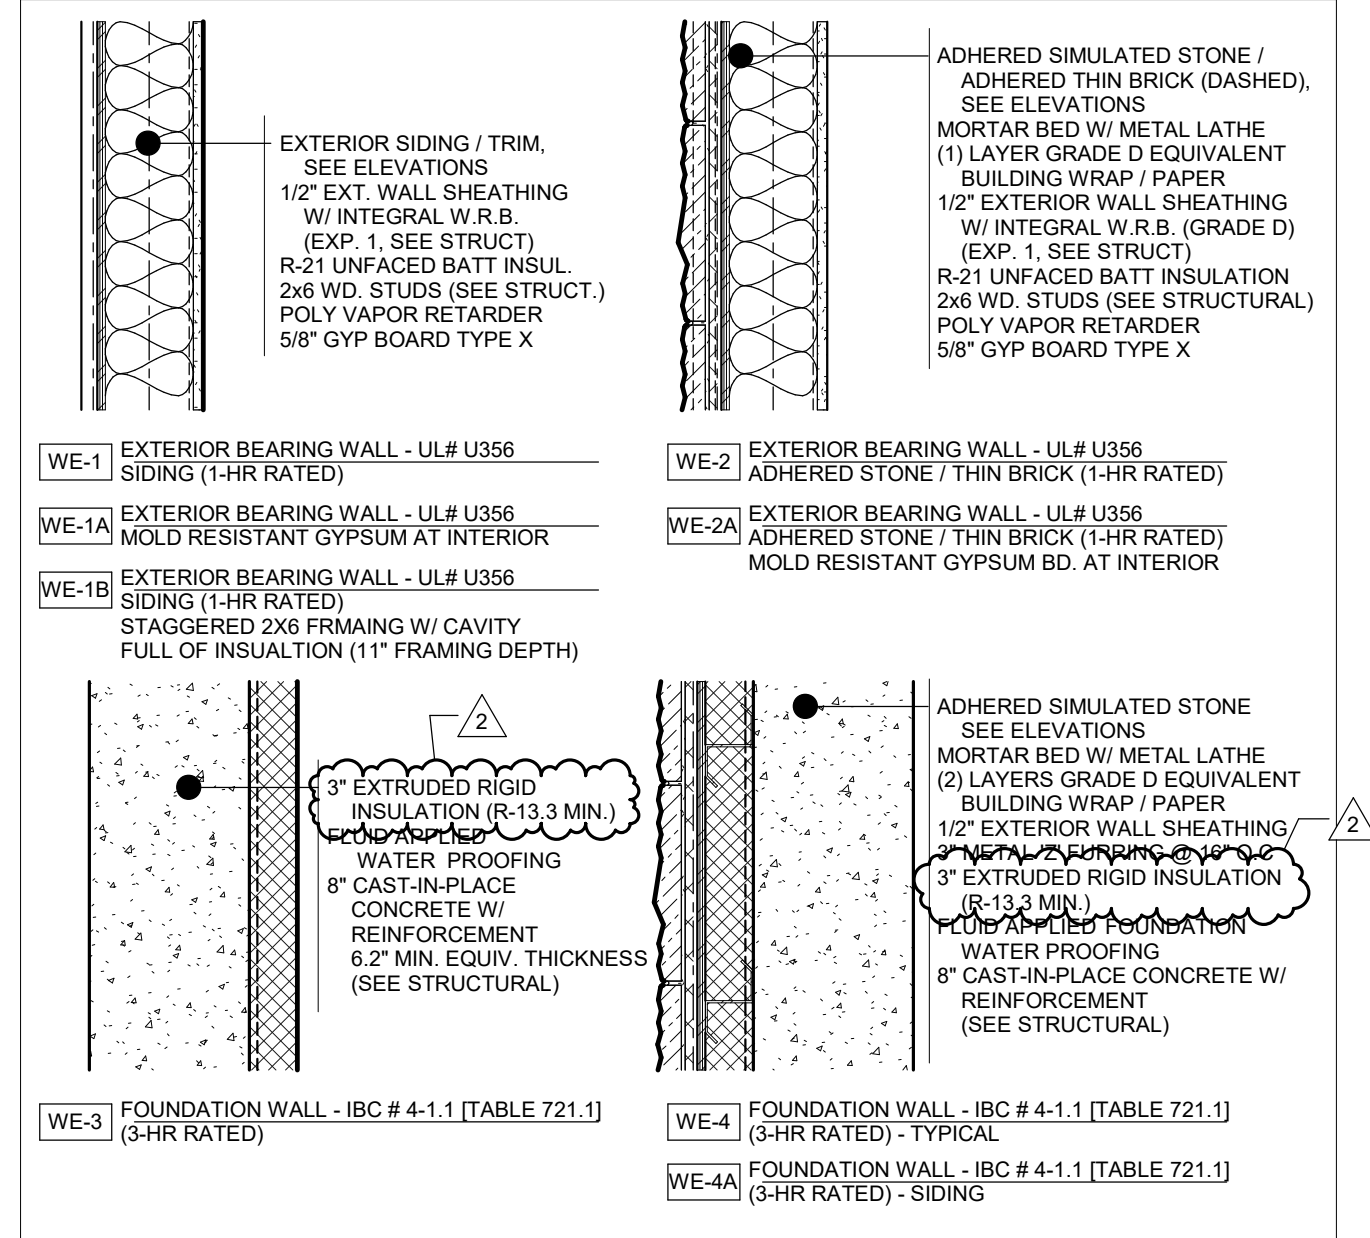

FLOOR / CEILING TYPES

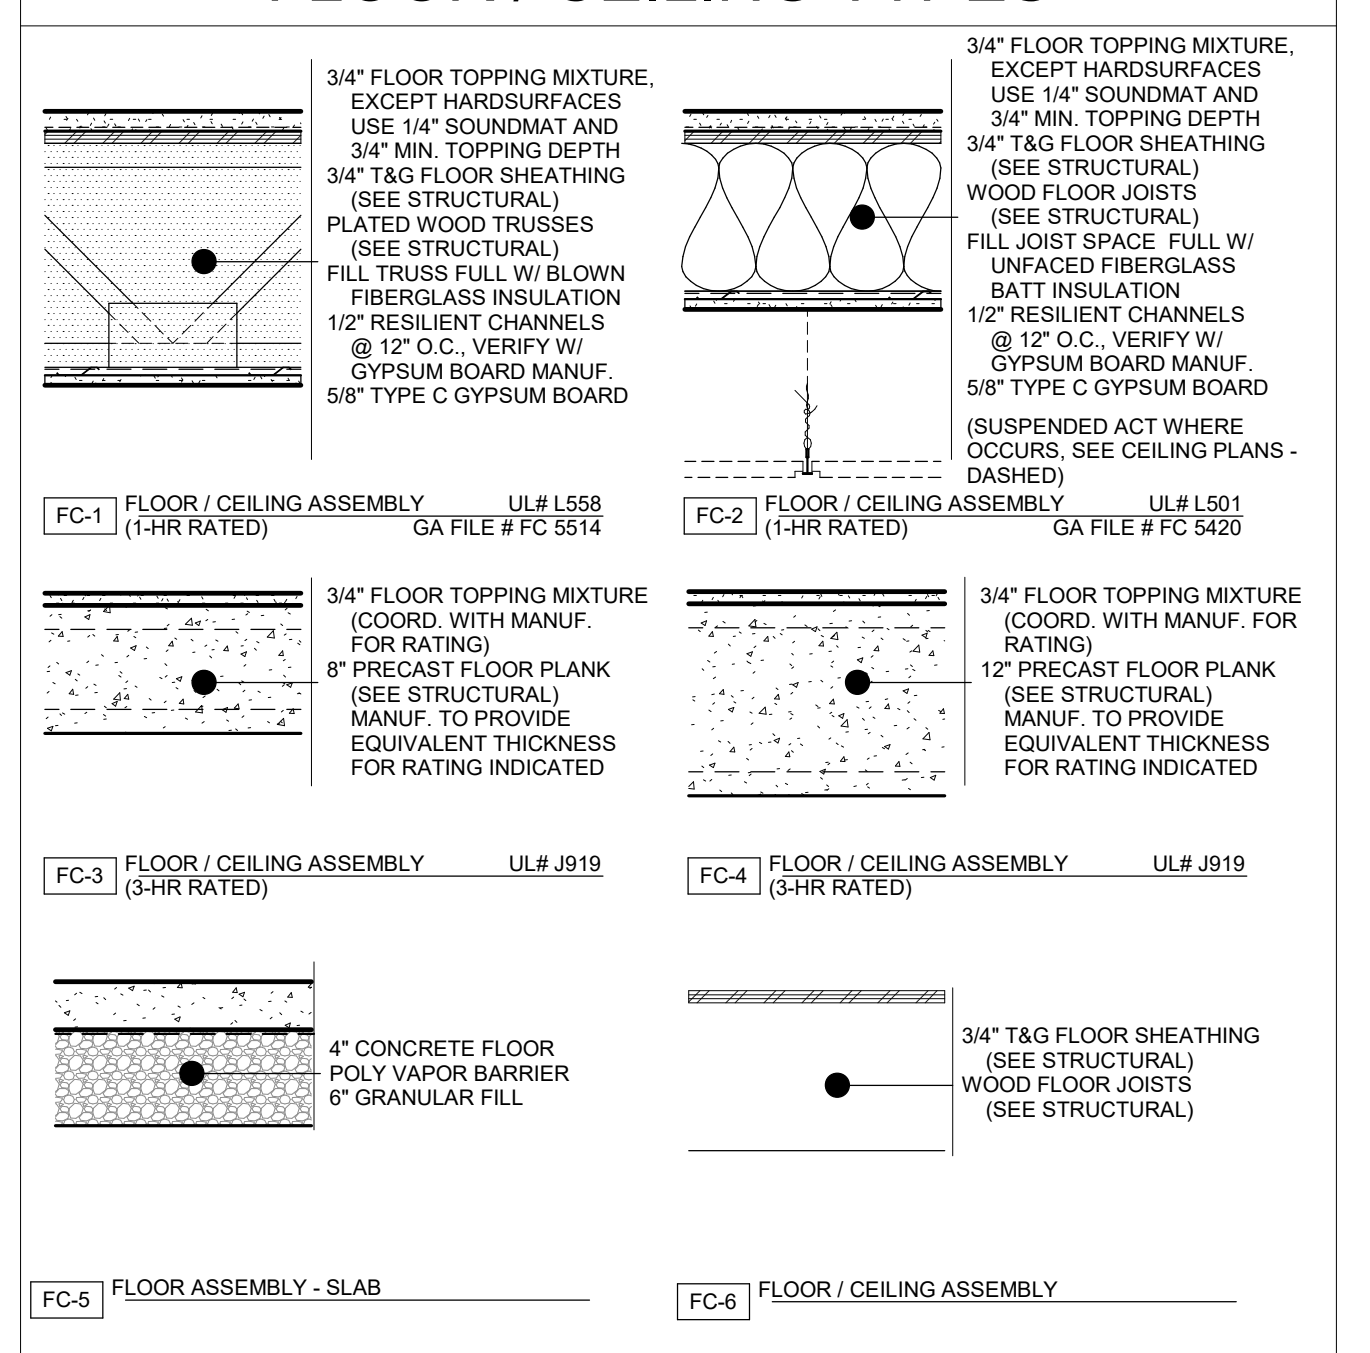

ROOF / CEILING TYPES

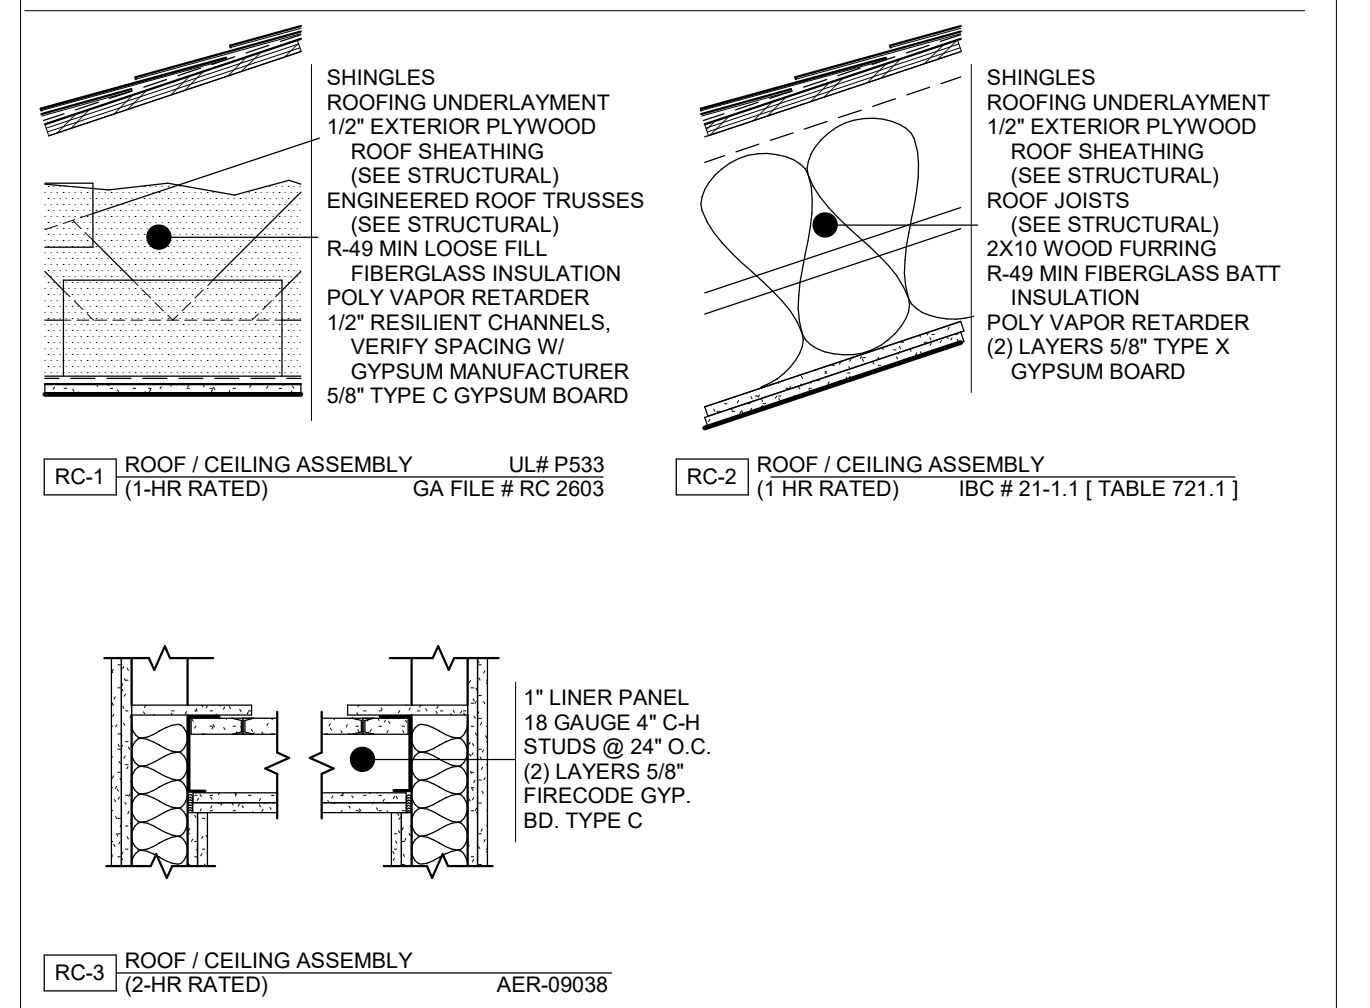

KEYNOTES - WALL SECTIONS

- 5.05 DRAIN TILE IN GRAVEL BED, VERIFY W/ PLUMBING FOR CONNECTION & SIZE. TIE TILE PIPING INTO STORM SYSTEM.
- 5.06 SPRAY FOAM INSULATION AS REQUIRED (R-21 MIN.)
- 5.25 VINYL PATIO DOOR OPENING AS SCHEDULED
- 5.29 JULIET RAILING, SEE DETAILS FOR ADDITIONAL INFORMATION
- 5.30 ACTUATOR PAD, SEE ACCESSIBLE DETAILS FOR ADDITIONAL INFORMATION



I hereby certify that this plan, specification or report was prepared by me or under my direct supervision & that I am a duly Licensed Architect under the laws of the State of Minnesota

Signature:

Printed Name: Tim Gillet
License No.: 51031
Date: 02/19/2021

These drawings and specifications are the sole property of HMA Architects, Ltd. any reproduction or reuse of these documents is forbidden without written permission from HMA Architects, Ltd.

Project No: 2037
Project Manager: DAS
Drawn By: NJT
Date: 02/19/2021

Date	Description
03/08/2021	Addendum 2



700 W. St. Germain Street
Suite 200
St. Cloud, MN 56301
www.hma-archs.com

T | 320.251.9155
F | 320.251.4919
hma@hma-archs.com

New Apartment Complex:

Zumbrota
Apartment
Complex

Zumbrota, MN

WALL SECTIONS

A506



THIRD STREET WEST

WEST AVENUE

FOURTH STREET WEST

EXISTING CONDITIONS AERIAL
AERIAL NOT TO SCALE



NOTES

- 1.) NO CONSTRUCTION MAY BEGIN UNTIL EROSION AND SEDIMENT CONTROLS ARE IN PLACE AND APPROVED BY THE CITY OF ZUMBROTA.
- 2.) NO CONSTRUCTION MAY BEGIN UNTIL A PRECONSTRUCTION MEETING IS HELD WITH THE CITY OF ZUMBROTA.
- 3.) PREVAILING SPECIFICATIONS: CITY OF ZUMBROTA, MNDOT SPECIFICATIONS, CEAM SPECIFICATIONS.
- 4.) NO CHANGES SHALL BE MADE TO APPROVED PLANS WITHOUT WRITTEN CONSENT OF THE CITY OF ZUMBROTA.
- 5.) ONLY CITY OF ZUMBROTA EMPLOYEES ARE PERMITTED TO OPERATE VALVES AND HYDRANTS.
- 6.) ELEVATIONS FOR CONNECTING TO EXISTING STUBS FOR SANITARY SEWER, WATER, AND STORM SEWER WILL NEED TO BE FIELD VERIFIED.
- 7.) EXISTING "AS-BUILT" INFO IS FROM TOPOGRAPHIC SURVEY.

INDEX TO PLAN SHEETS

Sheet Title	Sheet. No.
TITLE SHEET	1
LEGEND	2
ENGINEER'S NOTES	3-4
EXISTING CONDITIONS, AND DEMOLITION PLAN	5
SITE PLAN	6
GRADING PLAN	7
UTILITY PLAN	8
ROOF DRAIN PLAN	9
INLET PROTECTION DETAILS	10
SIDEWALK DETAILS	11-17
ENTRANCE AND PAVING DETAILS	18-23
UTILITY DETAILS	23-28
HYDROLOGY	29

THIS PLAN CONTAINS 29 TOTAL SHEETS

SITE ADDRESS

300 WEST AVENUE
ZUMBROTA, MN 55992

SITE LEGAL DESCRIPTION

BLOCK 4, ORIGINAL PLAT OF ZUMBROTA,
GOODHUE COUNTY, MINNESOTA.

ZONING

CURRENTLY ZONED: PUD

FLOOD INSURANCE RATE MAP


FIRM MAP NUMBER: 27049C0541E
EFFECTIVE DATE: SEPTEMBER 25, 2009

BENCHMARK

TOP NUT HYDRANT AT THE NORTHWEST QUADRANT
OF WEST AVENUE, AND WEST FOURTH STREET
ELEVATION = 983.38

UTILITY CONTACTS

CITY OF ZUMBROTA PUBLIC WORKS.....	507-732-7318
ZUMBROTA TELEPHONE COMPANY.....	507-732-5103
MINNESOTA ENERGY.....	800-889-9508
EXCEL ENERGY.....	507-732-5815
GOODHUE COUNTY CO-OP ELECTRICITY.....	507-732-5117
CHARTER.....	507-289-1611
FRONTIER.....	866-497-3059

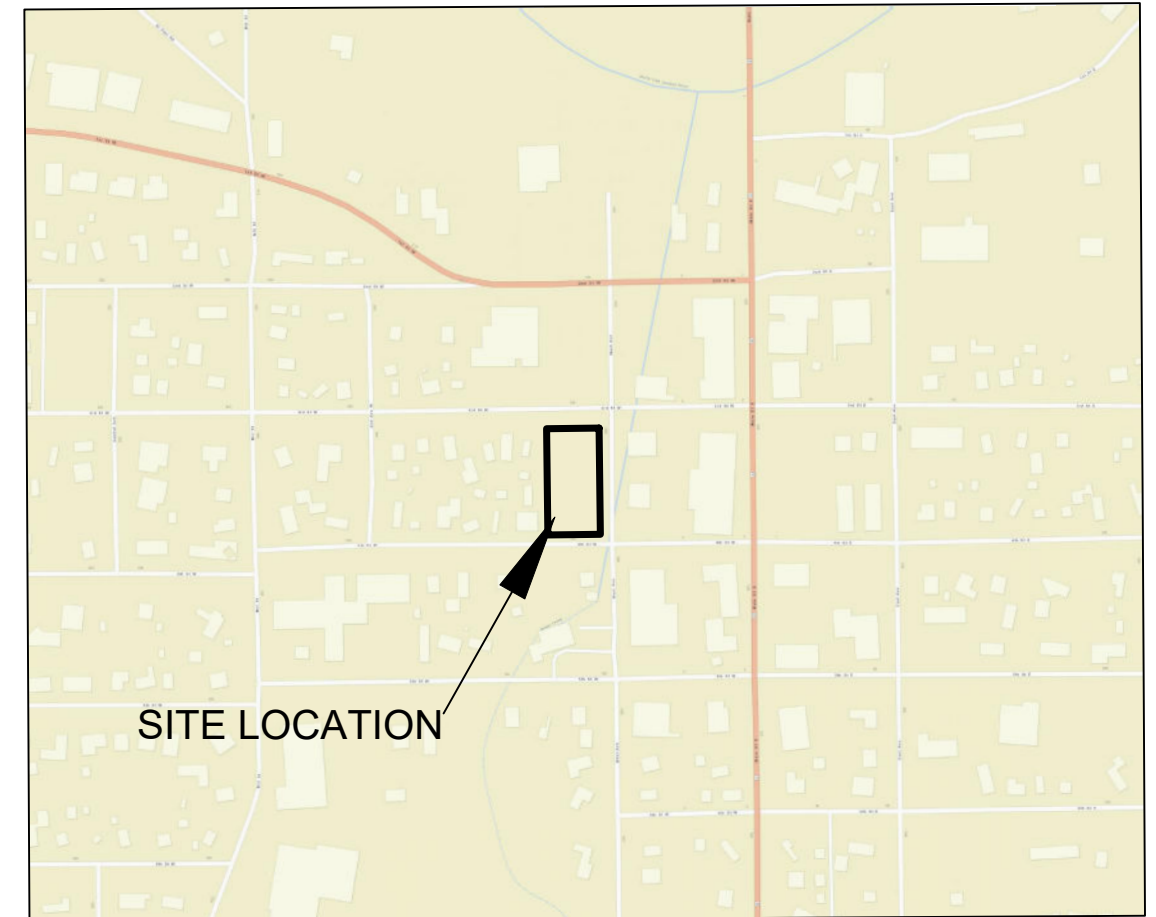

SITE LOCATION



VICINITY MAP
VICINITY MAP NOT TO SCALE

REVISION NOTES

- ADDENDUM #2 3/11/2021**
- SHEET 1: INDEX TO PLAN SHEETS WAS UPDATED.
 - SHEET 2: REJECT CURB ADDED TO LEGEND.
 - SHEET 5: ALLEY CURB ADDED TO DEMOLITION.
 - SHEET 6: ALL ENTRANCES AND PEDESTRIAN RAMPS REVISED. OUTSIDE PARKING REVISED TO ANGLED PARKING. CURB LOCATIONS AND DIMENSIONS REVISED FOR ENTRANCES AND PARKING AREA. NEW CURB WAS ADDED TO THE ALLEY.
 - SHEET 7: GRADES WERE REVISED TO MATCH SITE PLAN REVISIONS. FREE BOARD NOTE ADDED.
 - SHEET 8: CASTINGS AND RIM ELEVATIONS ADDED TO STRUCTURES. WATER LINE REALIGNED. ALL CATCH BASINS ARE TO BE REPLACED. MANUAL FLOOD VALVES ADDED TO SSFD1 AND SSFD2 FLOOR DRAINS.
 - SHEET 9: FRAME AND GRATE INFORMATION ADDED TO STRUCTURES.
 - SHEETS 10-29: ALL DETAILS HAVE BEEN UPDATED.
 - SHEET 29: OUTSIDE DROP MANHOLE REVISED TO BE AN INSIDE DROP MANHOLE.
 - SHEET 30: FREE BOARD NOTE ADDED.

CALL BEFORE YOU DIG
GOPHER STATE
ONE CALL

TWIN CITY AREA 651-454-0002
MIL TOLL FREE 1-800-252-1166

PATH: S/SHARE/PLATS/CITY OF ZUMBROTA/BLOCK 4/CIVIL/CAD

	BOUNDARY LINE
	EXISTING CURB AND GUTTER
	EXISTING OVERHEAD POWER LINE
	EXISTING POWER POLE
	EXISTING STORM SEWER LINE
	EXISTING STORM SEWER CATCH BASIN
	EXISTING STORM SEWER MANHOLE
	EXISTING WATER MAIN
	EXISTING WATER MAIN GATE VALVE
	EXISTING FIRE HYDRANT TO BE RELOCATED
	EXISTING SANITARY SEWER LINE
	EXISTING SANITARY SEWER MANHOLE
	EXISTING TELEPHONE PEDESTAL TO BE RELOCATED
	EXISTING CONTOUR AND ELEVATION
	EXISTING SPOT ELEVATION
	PROPOSED BIO LOGS
	PROPOSED INLET PROTECTION
	PROPOSED SAW CUT
	PROPOSED CURB AND GUTTER TO BE REMOVED
	EXISTING CONCRETE
	EXISTING BITUMINOUS
	EXISTING CONCRETE TO BE REMOVED
	EXISTING BITUMINOUS TO BE REMOVED
	PROPOSED CONCRETE
	PROPOSED BITUMINOUS
	PROPOSED B624 CURB AND GUTTER
	PROPOSED B624 CURB AND REJECT GUTTER
	PROPOSED WATER MAIN
	PROPOSED FIRE HYDRANT
	PROPOSED TELEPHONE PEDESTAL
	PROPOSED STORM SEWER
	PROPOSED STORM SEWER MANHOLE
	PROPOSED ROOF RAIN CONNECTION
	PROPOSED STORM SEWER CLEANOUT
	PROPOSED SANITARY SEWER
	PROPOSED SANITARY SEWER FLOOR DRAIN
	PROPOSED STORM SEWER FLOOR DRAIN
	PROPOSED GROUND SLOPE
	PROPOSED SPOT ELEVATION
	PROPOSED TOP OF CURB ELEVATION
	PROPOSED FLOWLINE OF CURB ELEVATION

REVISED	BY	DATE
ADDENDUM #2	SPD	3/11/2021

EROSION CONTROL NOTES

CONTRACTOR SHALL INSTALL PERIMETER BIO-LOGS BEFORE START OF ANY CONSTRUCTION ACTIVITY. TO PREVENT SEDIMENT RUNOFF FROM REACHING THE CURB OR STREET RIGHT OF WAY, PERIMETER DOWNSLOPE BIO-LOGS SHALL BE INSTALLED. BIO-LOGS MUST BE DOUBLE ROWED. JOINTS IN THE SECOND ROW OF BIO-LOGS MUST BE STAGGERED FROM JOINTS IN THE FIRST ROW OF BIO-LOGS.

TO PREVENT TRACKING OF DIRT ONTO HARD SURFACE STREET RIGHT-OF-WAY, ROCK CONSTRUCTION ENTRANCES SHALL BE INSTALLED AND MAINTAINED UNTIL VEHICLE ENTRANCES ONTO THE SITE ARE NO LONGER REQUIRED AND TOPSOIL IS SCHEDULED TO BE REPLACED. ALL VEHICLE ACCESS TO THIS SITE SHALL USE THE ROCK CONSTRUCTION ENTRANCES. SHOULD THE ROCK CONSTRUCTION ENTRANCES BECOME INEFFECTIVE DUE TO EXCESSIVE SOIL CONTAMINATION, THEY SHALL BE REMOVED AND REPLACED. SEE DETAIL.

THE CONTRACTOR SHALL SALVAGE SUFFICIENT TOPSOIL TO PROVIDE COVER AFTER GRADING OPERATIONS. ALL SOIL STOCKPILES AND FINISHED GRADED AREAS ARE TO BE SEEDED IMMEDIATELY IN ORDER TO ESTABLISH VEGETATION WITH WHEAT OR RYE GRASS @ 100 LB./ACRE DURING CONSTRUCTION. INSTALL AND MAINTAIN APPROVED INLET PROTECTION AT ALL ACTIVE STORM SEWER INLETS. SEE DETAILS. SEDIMENT RUNOFF SHOULD BE MINIMIZED BY RESPONSIBLE SITE EROSION CONTROL. EROSION CONTROL MEASURES MUST BE INSPECTED BY THE CITY BEFORE ANY GRADING ACTIVITY BEGINS. TO PREVENT SILT AND SEDIMENT FROM ENTERING THE STORM SEWER SYSTEM, A FILTER BAG INSERT, SEDIMENT CONTROL INLET HAT, ROCK LOG RING OR OTHER DEVICE APPROVED BY THE CITY, SHALL BE INSTALLED AT THE INLET. THE CONTRACTOR MAY DECIDE TO REMOVE ALL TOPSOIL FROM THE SITE, AND IMPORT BEFORE TURF ESTABLISHMENT.

ALL AREAS DISTURBED DURING CONSTRUCTION SHALL BE STABILIZED AS SOON AS POSSIBLE. AREAS THAT HAVE BEEN DISTURBED OR AT FINISH GRADE, BUT HAVE NO ACTIVE WORK, SHALL BE SEEDED AND MULCHED OR SODDED WITHIN 14 DAYS, EXCEPT ON SLOPES STEEPER THAN 4H:1V. STEEPER SLOPES SHALL BE SEEDED AND COVERED WITH AN EROSION CONTROL BLANKET OR SEEDED AND MULCHED WITH A TACKIFYING AGENT OR SODDED. AS SOON AS POSSIBLE AFTER GRADING OPERATIONS HAVE BEEN COMPLETED, TOPSOIL SHALL BE SPREAD AND THE ENTIRE SITE SHALL BE VEGETATED. FINAL SITE STABILIZATION SHALL BE EVIDENT WHEN SEEDED GRASS IS PRESENT ON ALL EXPOSED GRADING AREAS AND HAS GROWN TO A LENGTH OF 6 INCHES AND THERE ARE NO SIGNS OF ONGOING EROSION. IF SOD IS PLACED IN-LIEU OF SEED, IT SHALL BE WATERED AND MAINTAINED AND SHOW NO SIGNS OF STRESS FOR AT LEAST 30 DAYS. THE CITY SHALL APPROVE FINAL SITE STABILIZATION.

A NPDES STORM WATER PERMIT FOR CONSTRUCTION IS NOT REQUIRED FOR THIS PROJECT.

DEMOLITION NOTES

ALL ASPHALT TO REMAIN SHALL BE SAW CUT AT LIMITS OF REMOVAL.

REMOVE ALL DEMOLITION AND SALVAGED MATERIALS FROM SITE WITHIN 24 HOURS.

LOCATE AND PROTECT ALL UTILITY LINES PRIOR TO AND DURING DEMOLITION AND GRADING OPERATIONS. UTILITY LOCATIONS SHOWN ARE BASED ON BEST AVAILABLE INFORMATION AND ARE NOT GUARANTEED. THE CITY MAY REQUIRE A DISCONNECT PERMIT FOR SEWER AND WATER SERVICES.

CONTACT PRIVATE UTILITY SERVICE FOR ALL OTHER DISCONNECTS.

CONTACT PRIVATE UTILITY SERVICES FOR REROUTES.

SITE PLAN NOTES

ALL RADII AND PAVEMENT LENGTHS ARE TO THE EDGE OF BITUMINOUS AND CONCRETE OR TO THE FACE OF CURB UNLESS OTHERWISE NOTED.

DRIVEWAYS AND APRONS SHALL BE 8" CONCRETE.



SEE DETAILS FOR CONCRETE AND BITUMINOUS SECTIONS.

SEE ARCHITECTURAL DRAWINGS FOR BUILDING DIMENSIONS.

ALL EXTERIOR PARKING SPACES SHALL BE 60 DEGREE STALLS THAT ARE 9' WIDE AND 22' DEEP.

A GOPHER STATE ONE CALL WAS NOT MADE FOR THE DESIGN SURVEY. SURFACE EVIDENCE OF UTILITIES SUCH AS PEDESTALS, VALVES OR MANHOLES WERE LOCATED.

THE CONTRACTOR MUST COORDINATE WITH GOPHER STATE ONE TO LOCATE ALL UTILITIES.

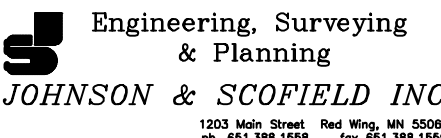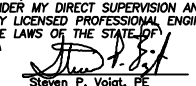 <p>Engineering, Surveying & Planning JOHNSON & SCOFIELD INC. 1203 Main Street Red Wing, MN 55086 ph. 651.388.1558 fax 651.388.1559</p>	I HEREBY CERTIFY THAT THIS PLAN, SPECIFICATION, OR REPORT WAS PREPARED BY ME OR UNDER MY DIRECT SUPERVISION AND I AM A DULY LICENSED PROFESSIONAL ENGINEER UNDER THE LAWS OF THE STATE OF MINNESOTA.  Steven P. Voigt, PE DATE 3-3-2021 REG. NO. 20034	DESIGNED SPD\SPV DRAWN SPD CHECKED SPV	<table border="1" style="width:100%; border-collapse: collapse;"> <thead> <tr> <th>REVISED</th> <th>BY</th> <th>DATE</th> </tr> </thead> <tbody> <tr><td> </td><td> </td><td> </td></tr> <tr><td> </td><td> </td><td> </td></tr> <tr><td> </td><td> </td><td> </td></tr> <tr><td> </td><td> </td><td> </td></tr> </tbody> </table>	REVISED	BY	DATE													LATEST REVISION: 3-11-21 Prepared For: ANDY BAARTMAN A-1 CLEANING P.O.B. 31 RED WING, MN 55066 PHONE: 651-301-5103	<h2>ZUMBROTA APARTMENTS</h2>	<h2>TITLE SHEET</h2>
	REVISED	BY	DATE																		
					<h2>ZUMBROTA, MN</h2>	<h3>SHEET 3 OF 29 SHEETS</h3>															

GRADING NOTES

AS SOON AS POSSIBLE AFTER GRADING OPERATIONS HAVE BEEN COMPLETED, TOPSOIL SHALL BE SPREAD AND THE ENTIRE SITE SHALL BE SEEDED AND MULCHED AS SOON AS PRACTICABLE TO MINIMIZE EROSION. FINAL SITE STABILIZATION SHALL BE EVIDENT WHEN SEEDED GRASS IS PRESENT ON ALL EXPOSED GRADING AREAS AND HAS GROWN TO A LENGTH OF 6 INCHES AND THERE ARE NO SIGNS OF ONGOING EROSION. IF SOD IS PLACED IN-LIEU OF SEED, IT SHALL BE WATERED AND MAINTAINED AND SHOW NO SIGNS OF STRESS FOR AT LEAST 30 DAYS.

UTILITY NOTES

WATERMAIN SHALL BE DUCTILE IRON CONFORMING TO AWWA C151 . ALL FITTINGS SHALL BE MECHANICAL DUCTILE IRON CONFORMING TO ASME B16.4, AWA C110, AWWA C153. (SEE MINNESOTA PLUMBING CODE CHAPTER 6, TABLE 604.1)

ALL WATER DISTRIBUTION SYSTEM SHALL BE DISINFECTED PER MINNESOTA RULES, PART 4715.2250 AND AWWA STANDARD C651.

A MINIMUM HORIZONTAL SEPARATION OF 10 FEET MUST BE MAINTAINED BETWEEN WATER SERVICE AND ANY SEWER WHENEVER POSSIBLE. A MINIMUM VERTICAL SEPARATION OF 18 INCHES MUST BE MAINTAINED BETWEEN WATER SERVICE AND ANY SEWER. THE WATER SERVICE SHALL NOT CONTAIN ANY JOINTS OR CONNECTIONS WITHIN 10 FEET OF THE CROSSING.

SEWERS CROSSING WHICH ARE NOT AT LEAST 12 INCHES BELOW A WATER SERVICE MUST BE CONSTRUCTED OF MATERIALS APPROVED FOR USE WITHIN A BUILDING (SEE SECTIONS 609.2, 720.1, AND TABLE 701.1). THE WATER SERVICE SHOULD NOT CONTAIN ANY JOINTS OR CONNECTIONS WITHIN 10 FEET OF THE CROSSING.

A MINIMUM 4" OF EXTRUDED POLYSTYRENE BOARD INSULATION SHALL BE INSTALLED ANYTIME WATER LINE CROSSES SANITARY SEWER, STORM SEWER, OR SUBDRAIN SYSTEM.

PVC SANITARY AND STORM SEWERS MUST MEET ONE OF THE FOLLOWING ASTM STANDARDS: D1785, D2665, D3034, F789, F794, F891, F949, OR F1488 (SEE TABLE 701.1 AND INSTALLATION STANDARD 1). FITTINGS MUST COMPLY WITH ASTM D1866, D2665, OR F794 RESPECTIVELY. JOINTS MUST BE APPROVED MECHANICAL OR PUSH-ON UTILIZING AN ELASTOMERIC SEAL, OR SOLVENT WELDED USING ASTM F656 PURPLE PRIMER AND ASTM D2564 SOLVENT CEMENT. THE INSTALLATION MUST COMPLY WITH ASTM D2321, WHICH REQUIRES OPEN-TRENCH INSTALLATION ON A CONTINUOUS GRANULAR BED. ASTM F679 PVC MAY BE USED FOR STORM SEWERS IF APPROVED BY THE LOCAL BUILDING OFFICIAL PRIOR TO INSTALLATION (SEE SECTION 301.2).

CONCRETE MANHOLES AND SEWER LINES SHALL BE TESTED BY NEGATIVE PRESSURE PER ASTM C1214-13, ASTM C1244-11, OR HYDROSTATICALLY PER "MN RULES 4714", SECTION 1109.2.2 (SEE ALSO SECTION 712.4).

INLET AND OUTLET CONNECTIONS TO SEWER MANHOLES MUST USE FLEXIBLE COMPRESSION JOINTS LOCATED BETWEEN 12 AND 36 INCHES FROM THE MANHOLE (SEE SECTION 719.6). WHERE PERMITTED BY THE ADMINISTRATIVE AUTHORITY AS AN ALTERNATE INSTALLATION METHOD, APPROVED RESILIENT RUBBER JOINTS MAY BE USED TO MAKE WATERTIGHT CONNECTIONS TO MANHOLES, CATCH BASINS, AND OTHER STRUCTURES (SEE SECTION 301.2).

THE PLUMBING SYSTEM AND THE STORM SYSTEM WITHIN 10 FEET OF THE BUILDING OR WATER SERVICE LINE MUST BE TESTED PER "MN RULES 4714", SECTIONS 609.4, 712.0, AND 1109.0.


ALL PVC INLET AND OUTLET CONNECTIONS TO A CONCRETE STRUCTURE SHALL BE MADE BY THE USE OF A FLEXIBLE COMPRESSION JOINT NOT LESS THAN 12 INCHES AND NOT EXCEEDING 3 FEET FROM THE MANHOLE. NO FLEXIBLE COMPRESSION JOINTS SHALL BE EMBEDDED IN THE MANHOLE BASE.

PROPOSED ELECTRIC INSTALLATION MUST BE COORDINATED WITH EXCEL. EXCEL STANDARDS SHALL BE FOLLOWED.

PROPOSED GAS INSTALLATION MUST BE COORDINATED WITH EXCEL. EXCEL STANDARDS SHALL BE FOLLOWED.

ALL CLEANOUTS IN PAVED AREAS SHALL BE PLACED IN A VALVE BOX. TOP OF VALVE BOX SHALL BE FLUSH WITH FINISHED PAVEMENT SURFACE.

Engineering, Surveying & Planning
JOHNSON & SCOFIELD INC.
 1203 Main Street Red Wing, MN 55066
 ph. 651.388.1558 fax 651.388.1559

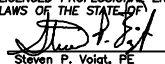I HEREBY CERTIFY THAT THIS PLAN, SPECIFICATION, OR REPORT WAS PREPARED BY ME OR UNDER MY DIRECT SUPERVISION AND I AM A DULY LICENSED PROFESSIONAL ENGINEER UNDER THE LAWS OF THE STATE OF MINNESOTA

 Steven P. Voigt, PE
 DATE 3-3-2021 REG. NO. 20034

DESIGNED SPD\SPV
 DRAWN SPD
 CHECKED SPV

REVISED	BY	DATE


LATEST REVISION: 3-11-21
 Prepared For:
ANDY BAARTMAN
 A-1 CLEANING
 P.O. B. 31
 RED WING, MN 55066
 PHONE: 651-301-5103

ZUMBROTA APARTMENTS
ZUMBROTA, MN

TITLE SHEET
SHEET 4 OF 29 SHEETS

NOTE: PRIOR TO ANY SIDEWALK OR CURB DEMOLITION THE CONTRACTOR SHALL SUBMIT A TRAFFIC CONTROL PLAN TO THE CITY FOR APPROVAL. THE TRAFFIC CONTROL PLAN SHALL SHOW WHERE THE PLACEMENT OF BARRICADES FOR PEDESTRIAN SAFETY.

NOTE: PRIOR TO ANY CURB DEMOLITION THE CONTRACTOR SHALL COORDINATE WITH THE SURVEYOR TO ASSURE THAT ENOUGH EXISTING SPOT ELEVATIONS ARE LOCATED TO INSURE THAT THE REPLACEMENT CURB MATCHES THE EXISTING HORIZONTAL AND VERTICLE CURB LOCATIONS.

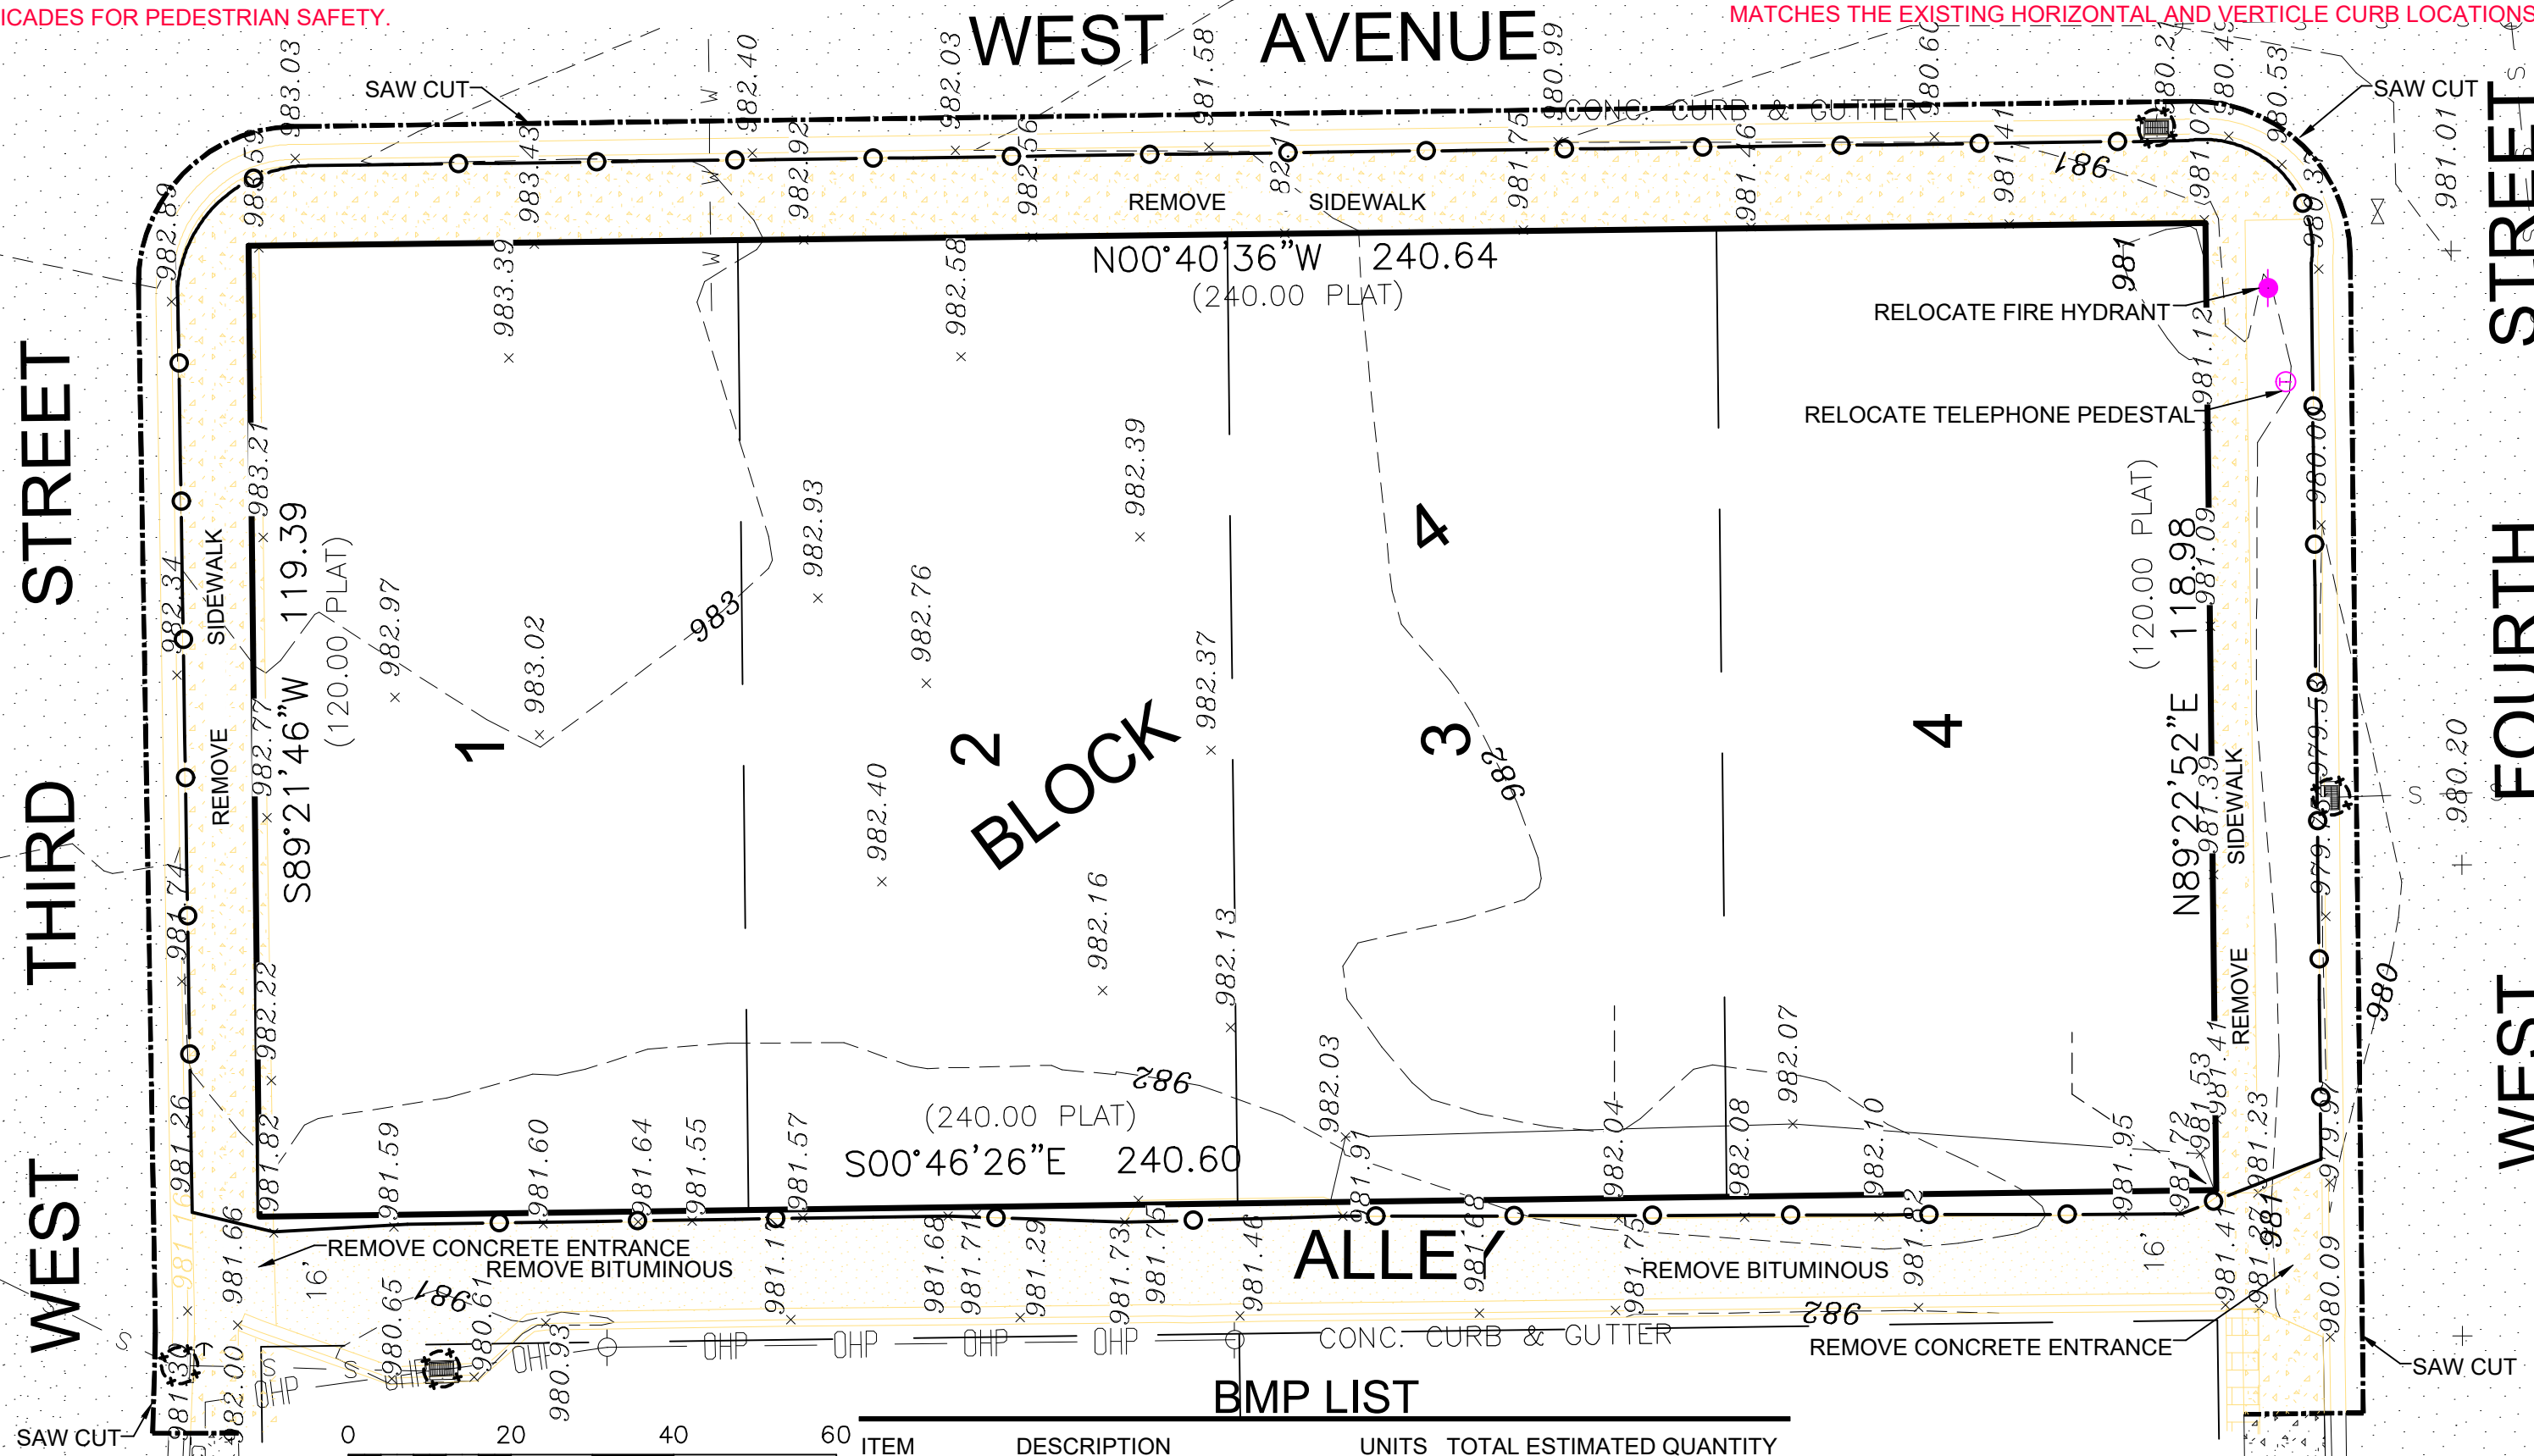

BMP LIST

ITEM	DESCRIPTION	UNITS	TOTAL ESTIMATED QUANTITY
1	BIO LOGS	LF	770
2	INLET PROTECTION	EA	4

Engineering, Surveying & Planning
JOHNSON & SCOFIELD INC.
 1203 Main Street Red Wing, MN 55066
 ph. 651.388.1558 fax 651.388.1559

I HEREBY CERTIFY THAT THIS PLAN, SPECIFICATION, OR REPORT WAS PREPARED BY ME OR UNDER MY DIRECT SUPERVISION AND I AM A DULY LICENSED PROFESSIONAL ENGINEER UNDER THE LAWS OF THE STATE OF MINNESOTA.
 Steven P. Voigt, PE
 DATE 3-3-2021 REG. NO. 20034


DESIGNED SPD/SPV
 DRAWN SPD
 CHECKED SPV

REVISED
 ADDENDUM #2
 BY SPD
 DATE 3/11/2021

LATEST REVISION: 3-11-21
 Prepared For:
 ANDY BAARTMAN
 A-1 CLEANING
 P.O.B. 31
 RED WING, MN 55066
 PHONE: 651-301-5103


ZUMBROTA APARTMENTS
ZUMBROTA, MN

EXISTING CONDITIONS
EROSION CONTROL AND
DEMOLITION PLAN
 SHEET 5 OF 29 SHEETS

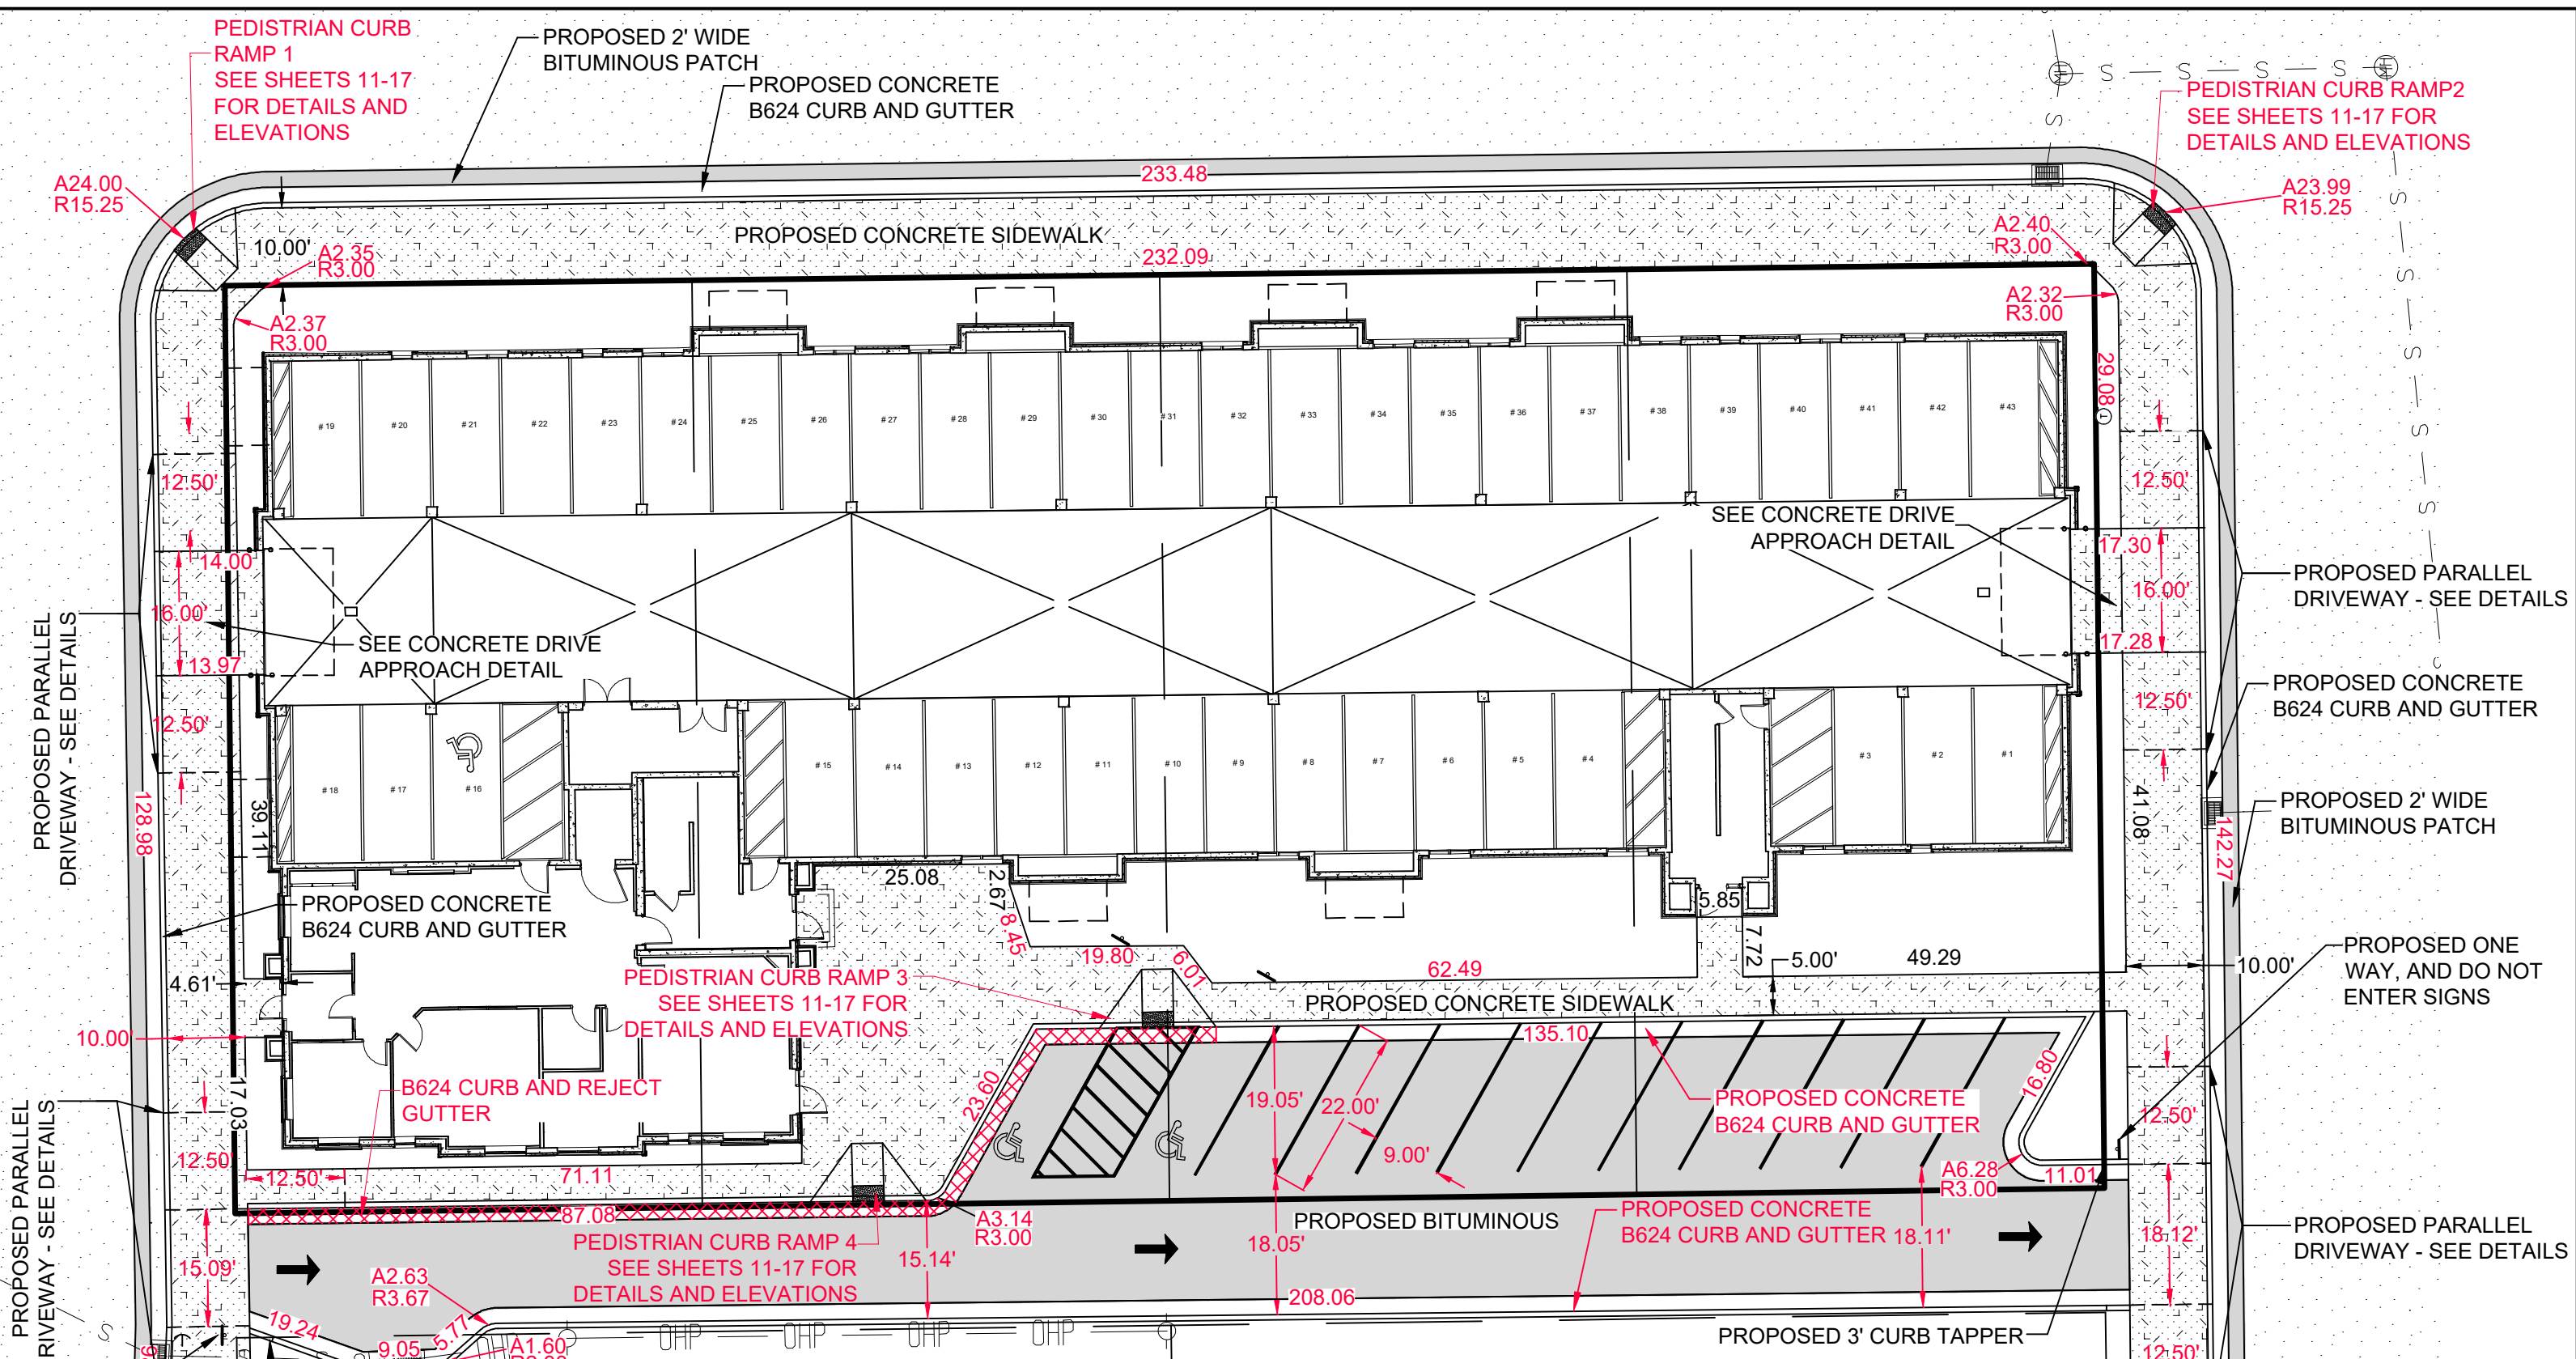

LOT AREA.....	0.66 ACRES (28,678 SF)
EXISTING IMPERVIOUS.....	0 SF (0%)
PROPOSED BUILDING FOOTPRINT.....	17,993 SF
PROPOSED CONCRETE.....	2,627 SF
PROPOSED BITUMINOUS.....	2,975 SF
TOTAL PROPOSED IMPERVIOUS AREA.....	0.54 ACRES, 23,595 SF (82%)
TOTAL PROPOSED GREEN SPACE.....	0.12 ACRES, 5,083 SF (18%)

*THESE AREAS ONLY INCLUDE SURFACES INSIDE THE PROPERTY BOUNDARY

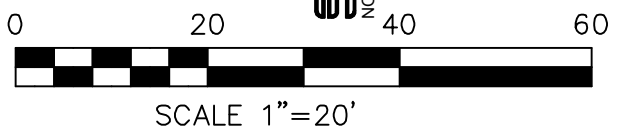

CALL BEFORE YOU DIG
GOPHER STATE
 ONE CALL
 TWIN CITY AREA 651-454-0002
 MN. TOLL FREE 1-800-252-1166

Engineering, Surveying & Planning
JOHNSON & SCOFIELD INC.
 1203 Main Street Red Wing, MN 55066
 ph. 651.388.1558 fax 651.388.1559

I HEREBY CERTIFY THAT THIS PLAN, SPECIFICATION, OR REPORT WAS PREPARED BY ME OR UNDER MY DIRECT SUPERVISION AND I AM A DULY LICENSED PROFESSIONAL ENGINEER UNDER THE LAWS OF THE STATE OF MINNESOTA
 Steven P. Voigt, PE
 DATE 3-3-2021 REG. NO. 20034

DESIGNED	SPD\SPV
DRAWN	SPD
CHECKED	SPV


REVISED	BY	DATE
ADDENDUM #2	SPD	3/11/2021

LATEST REVISION: 3-11-21
 Prepared For:
ANDY BAARTMAN
 A-1 CLEANING
 P.O.B. 31
 RED WING, MN 55066
 PHONE: 651-301-5103

ZUMBROTA APARTMENTS	SITE PLAN
ZUMBROTA, MN	SHEET 6 OF 29 SHEETS

CALL BEFORE YOU DIG
 GOPHER STATE
 ONE CALL
 TWIN CITY AREA 651-454-0002
 MINNAPOLIS AREA 1-800-252-1166

NOTE: BASE FLOOD ELEVATION IS 981.50

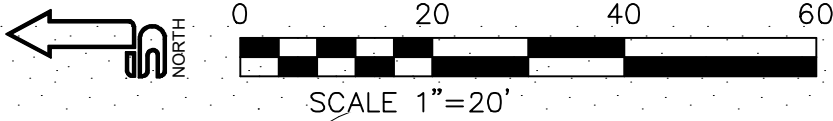

PEDISTRIAN CURB RAMP 1
 SEE SHEETS 11-17 FOR DETAILS AND ELEVATIONS

PEDISTRIAN CURB RAMP 2
 SEE SHEETS 11-17 FOR DETAILS AND ELEVATIONS

NOTE: 1.73' FREE BOARD BETWEEN FFE AND ALLEY CATCH BASIN.

PEDISTRIAN CURB RAMP 4
 SEE SHEETS 11-17 FOR DETAILS AND ELEVATIONS

PEDISTRIAN CURB RAMP 3
 SEE SHEETS 11-17 FOR DETAILS AND ELEVATIONS

NOTE: THE PROPOSED CURB ELEVATIONS SHALL MATCH THE EXISTING CURB PRIOR TO DEMOLITION.

Engineering, Surveying & Planning
JOHNSON & SCOFIELD INC.
 1203 Main Street Red Wing, MN 55066
 ph. 651.388.1558 fax 651.388.1559

I HEREBY CERTIFY THAT THIS PLAN, SPECIFICATION, OR REPORT WAS PREPARED BY ME OR UNDER MY DIRECT SUPERVISION AND I AM A DULY LICENSED PROFESSIONAL ENGINEER UNDER THE LAWS OF THE STATE OF MINNESOTA
 Steven P. Voigt, PE
 DATE 3-3-2021 REC. NO. 20034

DESIGNED	SPD\SPV
DRAWN	SPD
CHECKED	SPV

REVISED	BY	DATE
ADDENDUM #2	SPD	3/11/2021

LATEST REVISION: 3-11-21
 Prepared For:
ANDY BAARTMAN
 A-1 CLEANING
 P.O.B. 31
 RED WING, MN 55066
 PHONE: 651-301-5103

ZUMBROTA APARTMENTS
ZUMBROTA, MN

GRADING PLAN
SHEET 7 OF 29 SHEETS

CALL BEFORE YOU DIG

GOPHER STATE
ONE CALL

TWIN CITY AREA 651-454-0002
MN. TOLL FREE 1-800-252-1166

F&I NEENAH FRAME AND LID R-1429-CU OR EQUAL
RIM ELEV: 983.40

F&I 6" OUTSIDE DROP FROM SSFD4
UPPER DROP INV: 972.98
LOWER DROP INV IN: 968.92
6" SDR 26 SERVICE FROM BUILDING
PLUMBING INV IN: 968.92
EXISTING 6" INV OUT: 968.82
SANITARY SERVICE LOCATION IS
APPROXIMATE, AND MUST BE FIELD VERIFIED.

CUT EXISTING 6" D.I.P.
F&I 6" D.I.P. 90° BEND
F&I CONCRETE THRUST BLOCK
F&I 6.4 L.F. 6" D.I.P.

F&I 6" D.I.P. 90° BEND
F&I CONCRETE THRUST BLOCK
F&I 5 L.F. 6" D.I.P.

F&I 6" D.I.P. GATE VALVE
F&I VALVE BOX
F&I 4.8 L.F. 6" D.I.P.

STCB2
REPLACE EXISTING CATCH BASIN, FRAME,
AND GRATE
GRATE: 980.25
EXISTING 12" RCP INV: 976.57
PROPOSED 12" ADS INV: 976.67
F&I 15.5 LF 12" SDR26 @ 1.0% TO STRD 6

CONNECT 6" D.I.P. WATER MAIN TO BUILDING.
CONNECT 6" SCH 40 PVC SANITARY SEWER TO BUILDING PLUMBING.

RELOCATED TELEPHONE PEDESTAL

RELOCATED FIRE HYDRANT

F&I 37 L.F. 6" SCH 40 PVC @ 1.0%

SSFD 4
F&I FLOOR DRAIN-SEE ARCH.
PLANS
GRATE :982.12
12" SCH 40 PVC INV IN: 973.43
12" SCH 40 PVC INV OUT: 973.33

SSFD 1
F&I FLOOR DRAIN-SEE ARCH. PLANS
F&I MANUAL FLOOD SHUT OFF VALVE
GRATE :980.16
12" SCH 40 PVC INV: 975.00

F&I 35.8 L.F. 6" SCH 40 PVC @ 1.0%

F&I 52.2 L.F. 12" SDR26 @ 1.0%

F&I 49.3 L.F. 12" SCH 40 PVC @ 1.0%

F&I 49.9 L.F. 6" SCH 40 PVC @ 1.0%

SSFD 3
F&I FLOOR DRAIN-SEE ARCH. PLANS
GRATE :981.53
6" SCH 40 PVC INV: 973.95

SSFD 2
F&I FLOOR DRAIN-SEE ARCH. PLANS
F&I MANUAL FLOOD SHUT OFF VALVE
GRATE :980.93
12" SCH 40 PVC INV: 974.50

SSFD 5
F&I FLOOR DRAIN-SEE ARCH. PLANS
GRATE :982.53
6" SCH 40 PVC INV: 973.78


STCB1
REPLACE EXISTING CATCH BASIN, FRAME, AND GRATE. SEE DETAILS.
GRATE: 979.53
EXISTING 12" RCP INV: 976.63
PROPOSED 12" SDR26 INV: 976.73
F&I 8 LF 12" SDR26 @ 0.50% TO STMH 1

STCB 4
F&I CATCH BASIN
F&I NEENAH FRAME AND GRATE R-3070 OR EQUAL
GRATE: 980.10
IN 12" SDR26 NE INV: 976.27
OUT 12" SDR26 NE INV: 977.17
F&I 33.0 LF 12" SDR26 @ 1% TO STRD 4

STCB5
REPLACE EXISTING CATCH BASIN, FRAME, AND GRATE SEEDATILS
GRATE: 981.02
EXISTING 10" RCP INV: 975.04
EXISTING 12" PVC INV: 974.89
PROPOSED 12" SDR26 INV: 975.04
F&I 15 LF 12" SDR26 @ 1.0% TO STCO 1

STCB4
REPLACE EXISTING CATCH BASIN, FRAME, AND GRATE SEE DETAILS
GRATE: 980.70
EXISTING 10" RCP INV: 975.75

NOTE: EXISTING UTILITY ELEVATIONS ARE FROM AS-BUILT PLANS. ALL CONNECTION ELEVATIONS MUST BE FIELD VERIFIED.

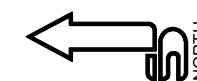

SCALE 1"=20'

Engineering, Surveying & Planning
JOHNSON & SCOFIELD INC.
1203 Main Street Red Wing, MN 55066
ph. 651.388.1558 fax 651.388.1559

I HEREBY CERTIFY THAT THIS PLAN, SPECIFICATION, OR REPORT WAS PREPARED BY ME OR UNDER MY DIRECT SUPERVISION AND I AM A DULY LICENSED PROFESSIONAL ENGINEER UNDER THE LAWS OF THE STATE OF MINNESOTA
Steven P. Voigt, PE
DATE 3-3-2021 REC. NO. 20034

DESIGNED	SPD\SPV
DRAWN	SPD
CHECKED	SPV

REVISED	BY	DATE
ADDENDUM #2	SPD	3/11/2021

LATEST REVISION: 3-11-21
Prepared For:
ANDY BAARTMAN
A-1 CLEANING
P.O.B. 31
RED WING, MN 55066
PHONE: 651-301-5103


ZUMBROTA APARTMENTS
ZUMBROTA, MN

UTILITY PLAN
SHEET 8 OF 29 SHEETS

CALL BEFORE YOU DIG

GOPHER STATE
ONE CALL

TWIN CITY AREA 651-454-0002
MN. TOLL FREE 1-800-252-1166

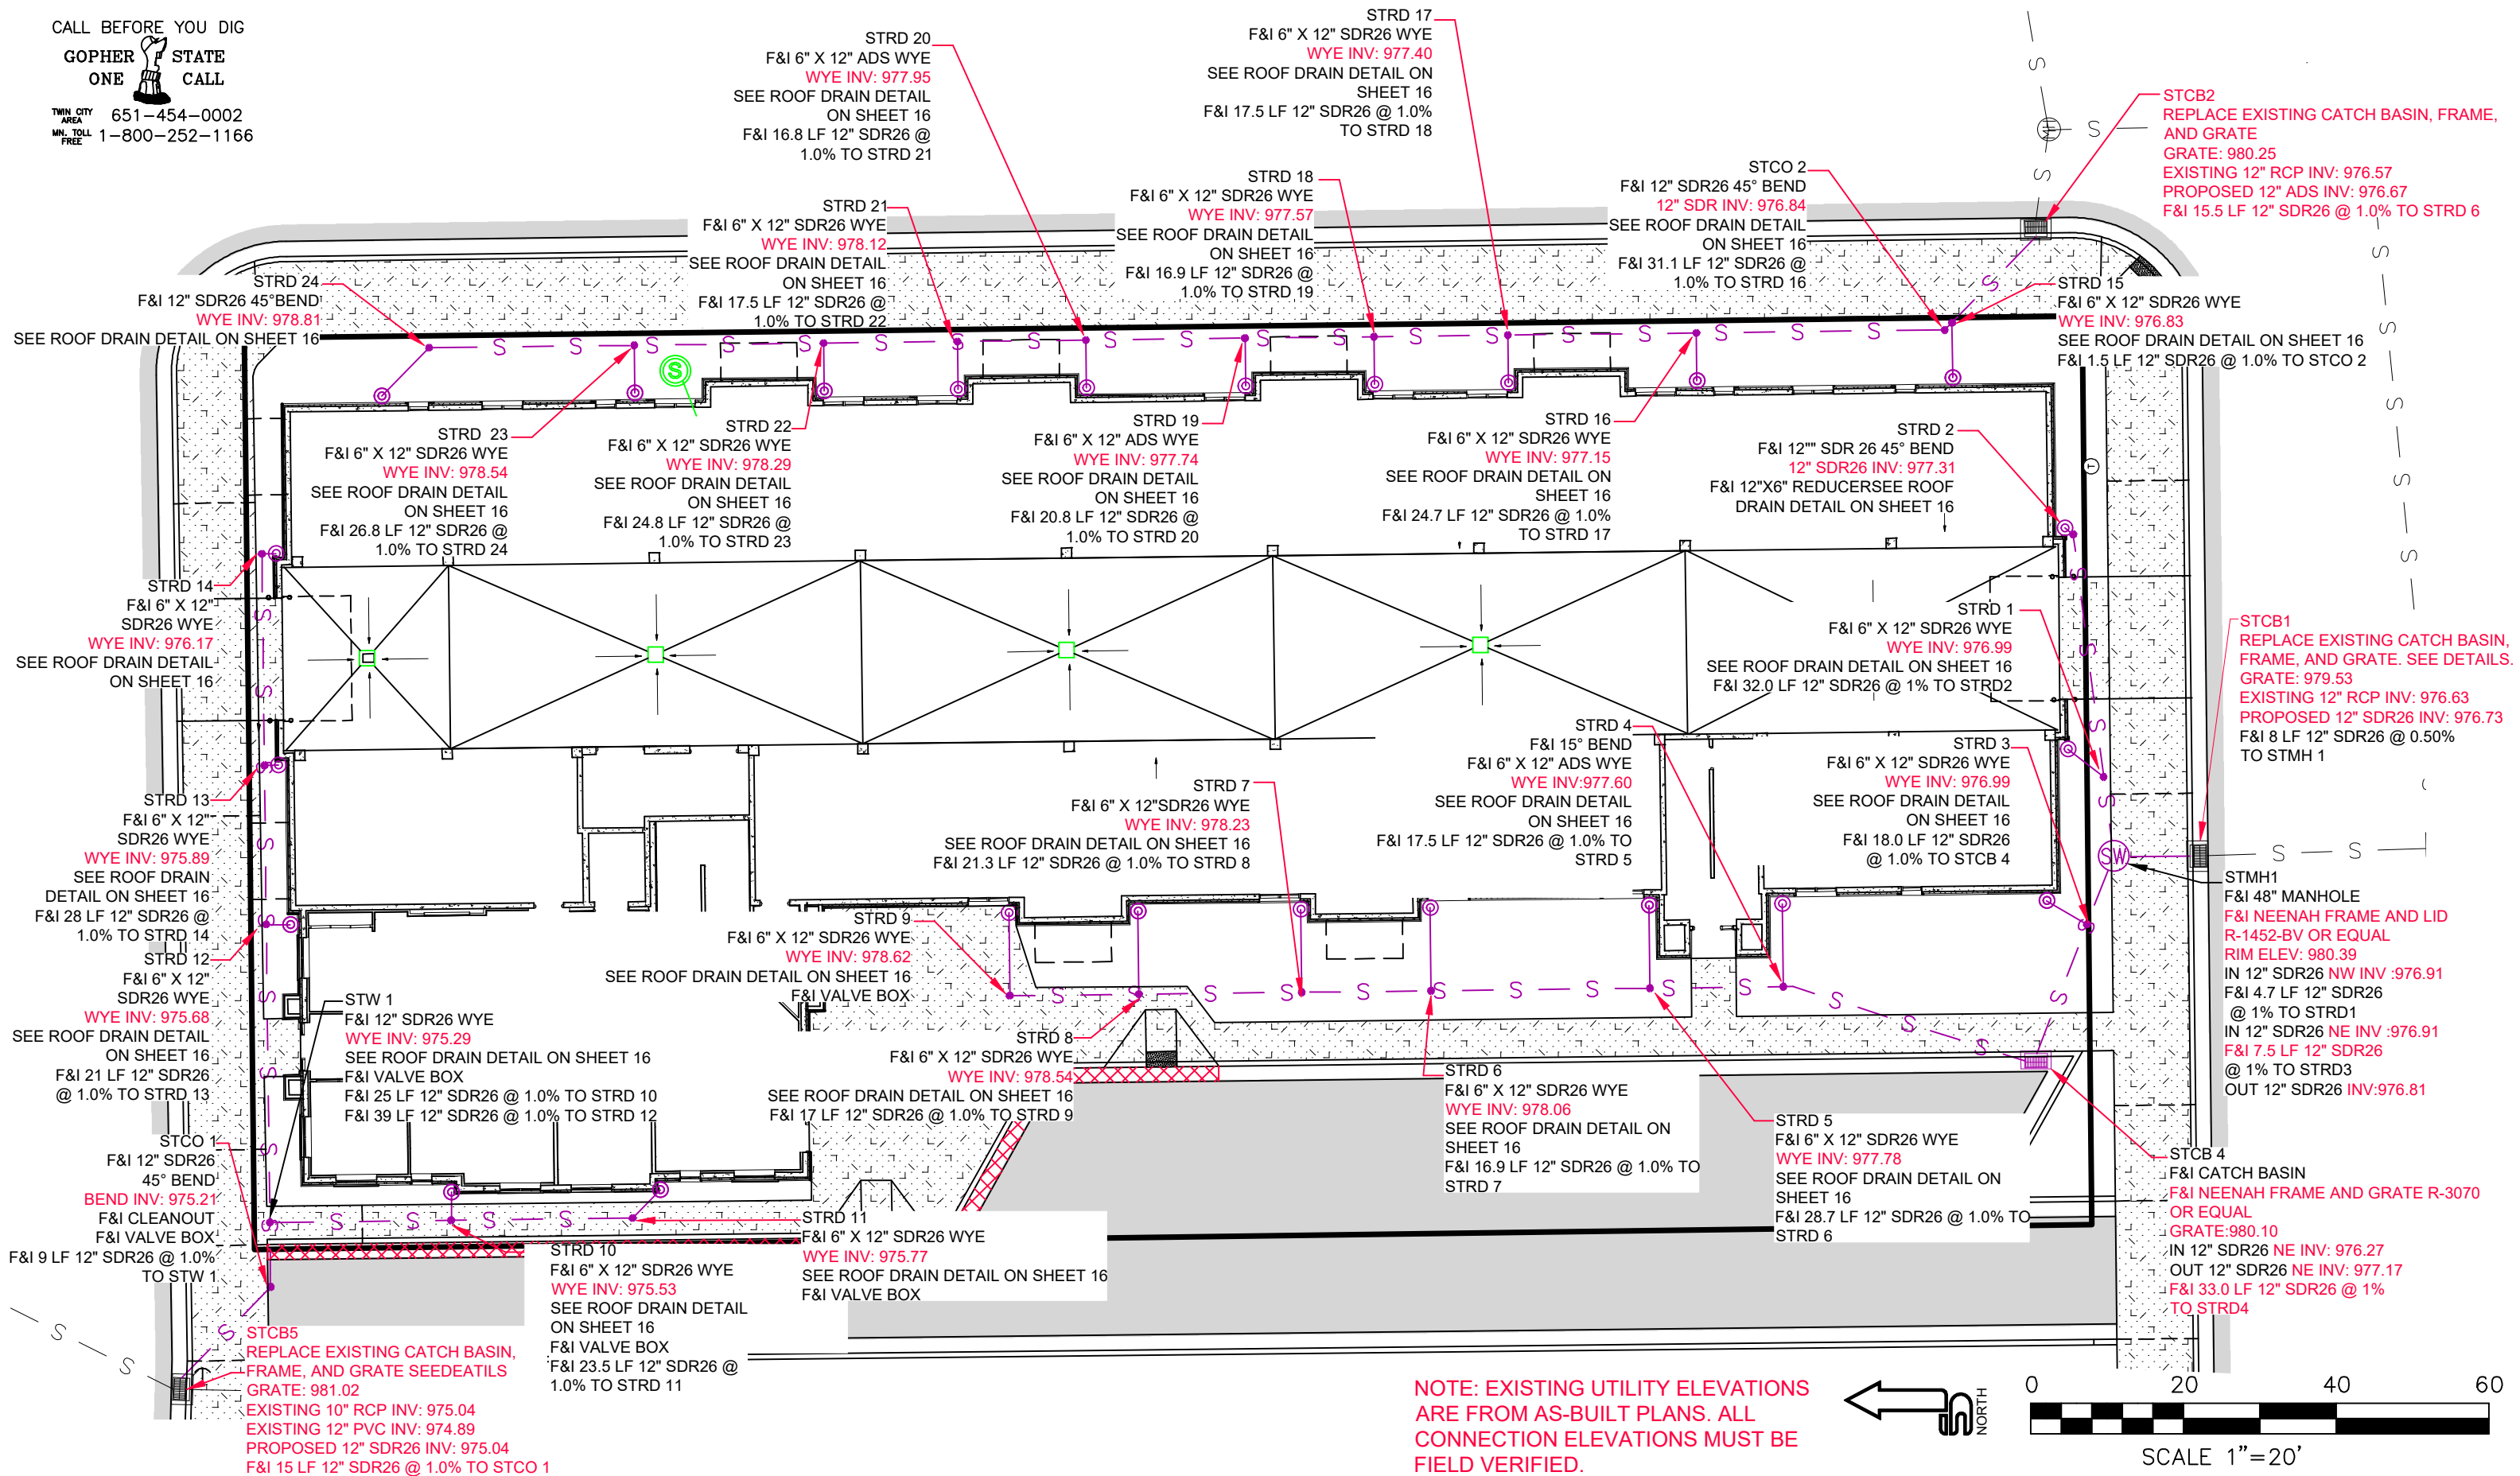

Engineering, Surveying & Planning
JOHNSON & SCOFIELD INC.
 1203 Main Street Red Wing, MN 55066
 ph. 651.388.1558 fax 651.388.1559

I HEREBY CERTIFY THAT THIS PLAN, SPECIFICATION, OR REPORT WAS PREPARED BY ME OR UNDER MY DIRECT SUPERVISION AND I AM A DULY LICENSED PROFESSIONAL ENGINEER UNDER THE LAWS OF THE STATE OF MINNESOTA
 Steven P. Voigt, PE
 DATE 3-3-2021 REC. NO. 20034


DESIGNED SPD\SPV
 DRAWN SPD
 CHECKED SPV

REVISED	BY	DATE
ADDENDUM #2	SPD	3/11/2021

LATEST REVISION: 3-11-21
 Prepared For:
 ANDY BAARTMAN
 A-1 CLEANING
 P.O.B. 31
 RED WING, MN 55066
 PHONE: 651-301-5103

ZUMBROTA APARTMENTS
ZUMBROTA, MN

ROOF DRAIN PLAN
SHEET 9 OF 29 SHEETS

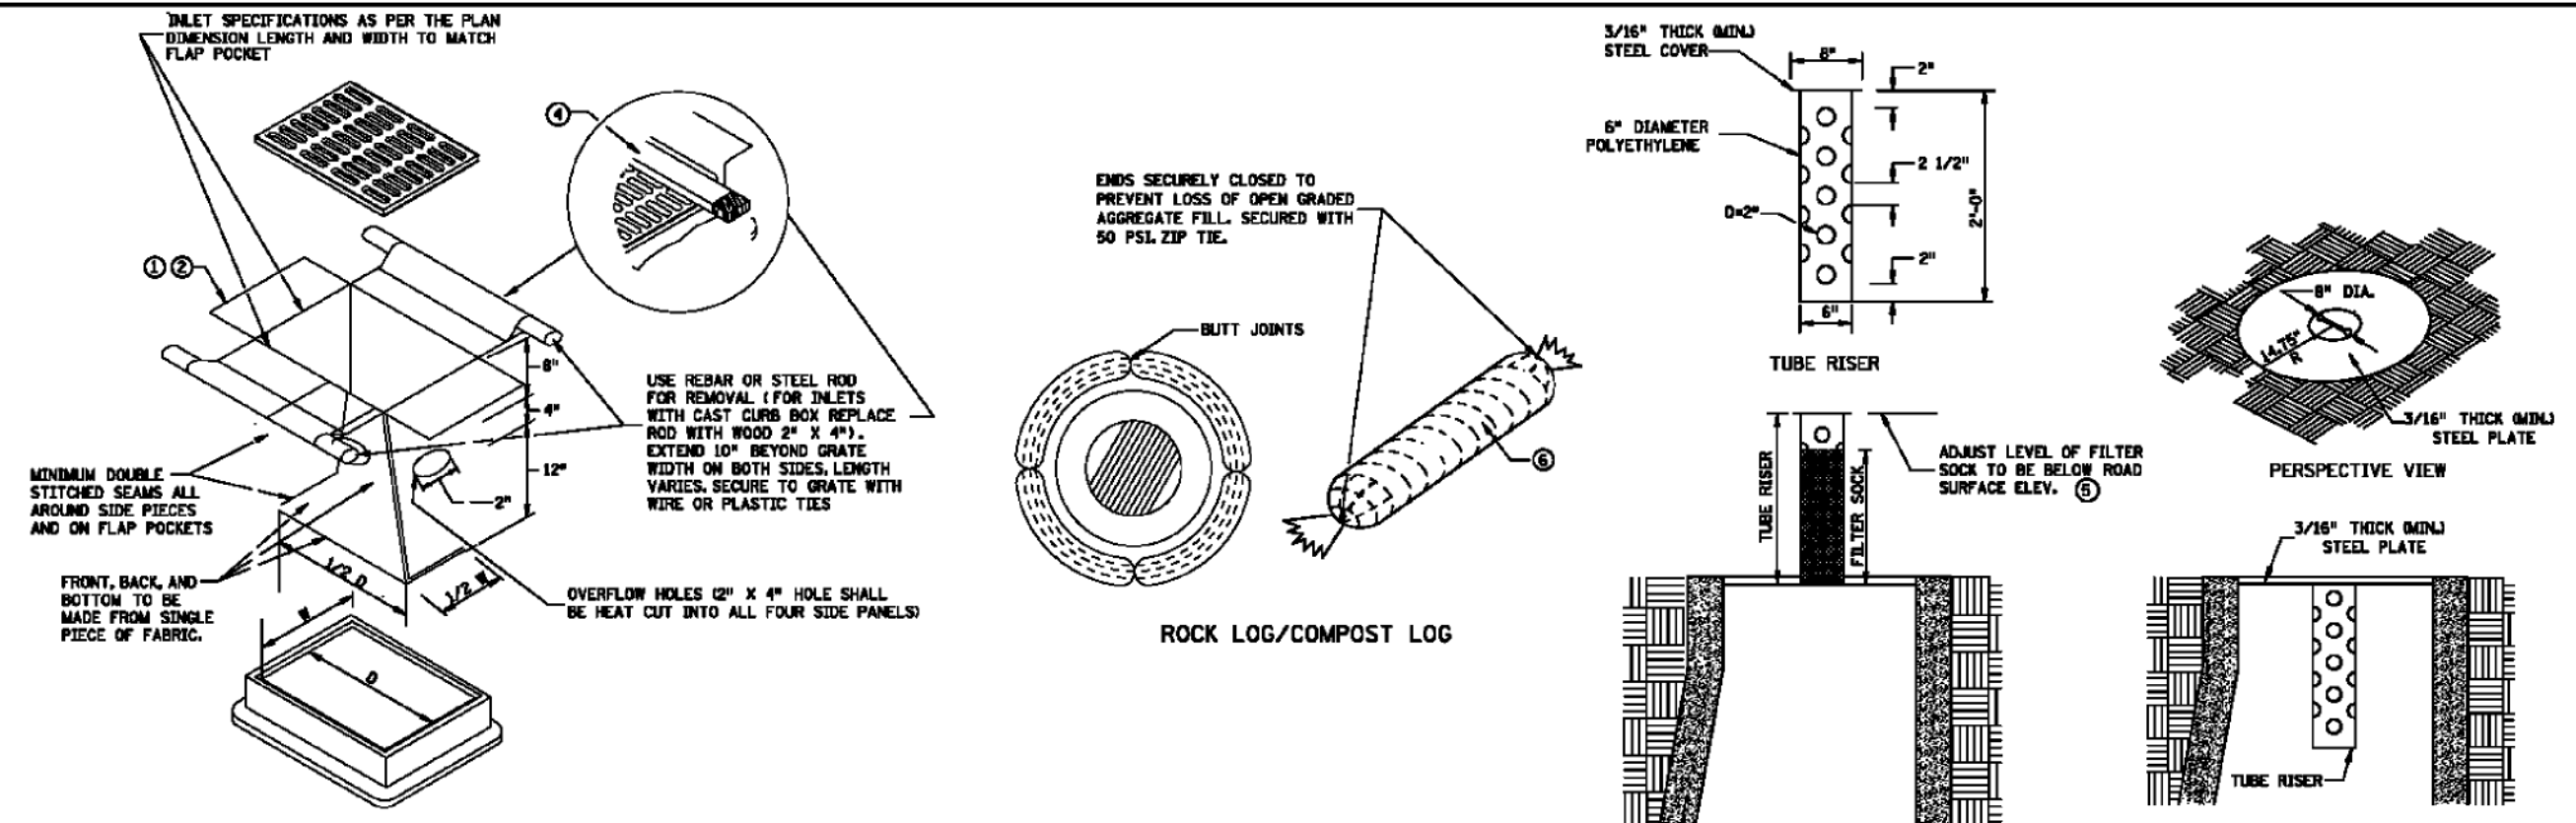


FILTER BAG INSERT ③
 (CAN BE INSTALLED IN ANY INLET TYPE WITH OR WITHOUT A CURB BOX)

ROCK LOG/COMPOST LOG


SECTION (UP POSITION) **SECTION (DOWN POSITION)**

POP-UP HEAD

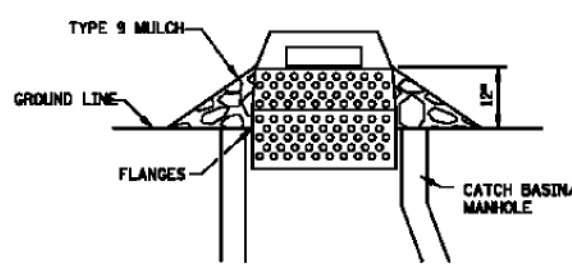

SEDIMENT CONTROL INLET HAT

NOTE:
 THE SEDIMENT CONTROL BARRIER SHALL BE A METAL OR PLASTIC/POLYETHYLENE RISER SIZED TO FIT INSIDE THE CATCH BASIN/MANHOLE; HAVE PERFORATIONS TO ALLOW FOR WATER INFILTRATION; HAVE AN OVERFLOW OPENING, FLANGES AND A LID/COVER.

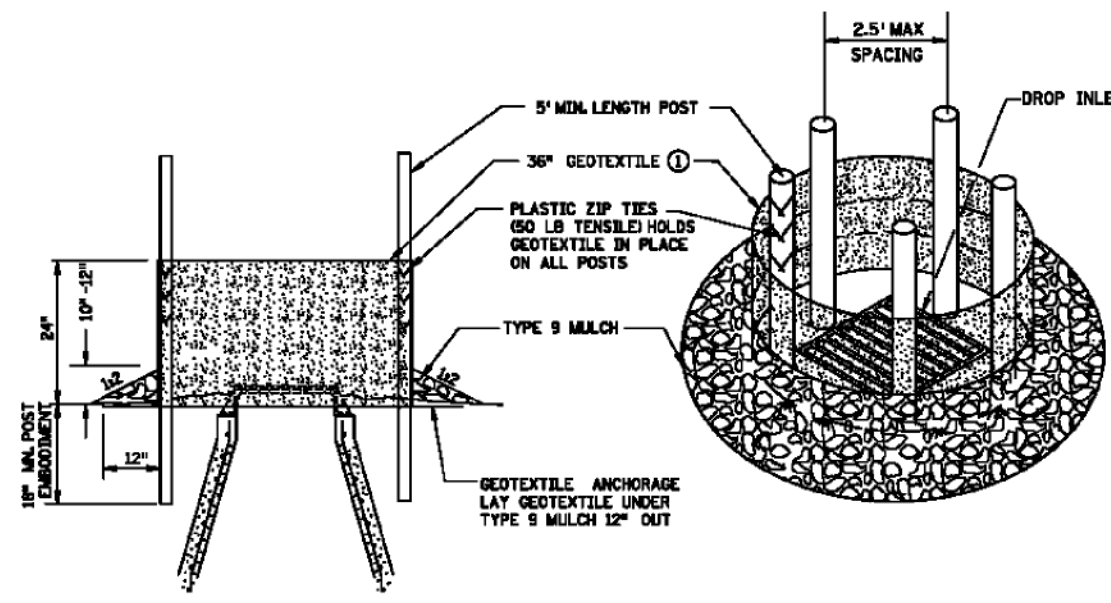

SILT FENCE RING AND ROCK FILTER BERM
 USE WHERE INLET DRAINS IN AN AREA WITH SLOPES AT 1:3 OR LESS

NOTES:










- SEE SPECS. 2573, 3137, 3886 & 3891.
- MANUFACTURED ALTERNATIVES LISTED ON Mn/DOT'S APPROVED PRODUCTS LIST MAY BE SUBSTITUTED.
- ① ALL GEOTEXTILE USED FOR INLET PROTECTION SHALL BE MONOFILAMENT IN BOTH DIRECTIONS, MEETING SPEC. 3886.
- ② FINISHED SIZE, INCLUDING POCKETS WHERE REQUIRED SHALL EXTEND A MINIMUM OF 10 INCHES AROUND THE PERIMETER TO FACILITATE MAINTENANCE OR REMOVAL.
- ③ **INSTALLATION NOTES:**
 DO NOT INSTALL FILTER BAG INSERT IN INLETS SHALLOWER THAN 30 INCHES, MEASURED FROM THE BOTTOM OF THE INLET TO THE TOP OF THE GRATE. THE INSTALLED BAG SHALL HAVE A MINIMUM SIDE CLEARANCE OF 3 INCHES BETWEEN THE INLET WALLS AND THE BAG, MEASURED AT THE BOTTOM OF THE OVERFLOW HOLES. WHERE NECESSARY THE CONTRACTOR SHALL CLINCH THE BAG, USING PLASTIC ZIP TIES, TO ACHIEVE THE 3 INCH SIDE CLEARANCE.
- ④ FLAP POCKETS SHALL BE LARGE ENOUGH TO ACCEPT WOOD 2 INCH X 4 INCH OR USE A ROCK SOCK OR SAND BAGS IN PLACE OF THE FLAP POCKETS.
- ⑤ SOCK HEIGHT MUST NOT BE SO HIGH AS TO SLOW DOWN WATER FILTRATION TO CAUSE FLOODING OF THE ROADWAY.
- ⑥ GEOTEXTILE SOCK BETWEEN 4-10 FEET LONG AND 4-6 INCH DIAMETER. SEAM TO BE JOINED BY TWO ROWS OF STITCHING WITH A PLASTIC MESH BACKING OR PROVIDE A HEAT BONDED SEAM (OR APPROVED EQUIVALENT). FILL ROCK LOG WITH OPEN GRADED AGGREGATE CONSISTING OF SOUND DURABLE PARTICLES OF COARSE AGGREGATE CONFORMING TO SPEC. 3137 TABLE 3137-1a CA-3 GRADATION.

STANDARD SHEET NO. 5-297.405 (4 OF 4)	TITLE TEMPORARY SEDIMENT CONTROL STORM DRAIN INLET PROTECTION
STANDARD APPROVED MARCH 29, 2012	
STATE PROJ. NO.	(TH) SHEET NO. OF SHEETS

MARCH 29, 2012 5-297.405 (4 OF 4)

DESIGNED	BY	DATE
SPD\SPV	SPD	3/11/2021
DRAWN	SPD	
CHECKED	SPV	

DISTRICT #: DISTRICT *
 USER NAME: \$\$\$\$USER\$\$\$NAME\$\$\$
 PATH & FILENAME: Documents/Operations/ADA_Review/ADA_Design/Standard/ADA_spaces/Standards/Detail/s&s&spaces/Detail/s&s&spaces/Ramp&spaces/Std.s&s&spot
 FILE NAME: \$\$\$\$FILENAME\$\$\$

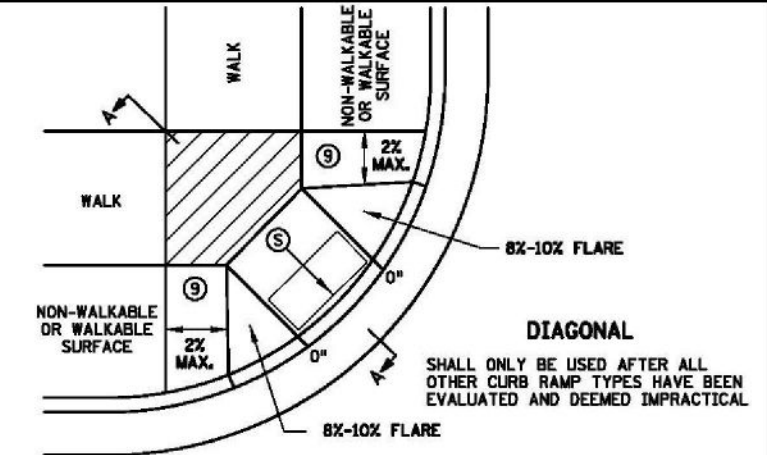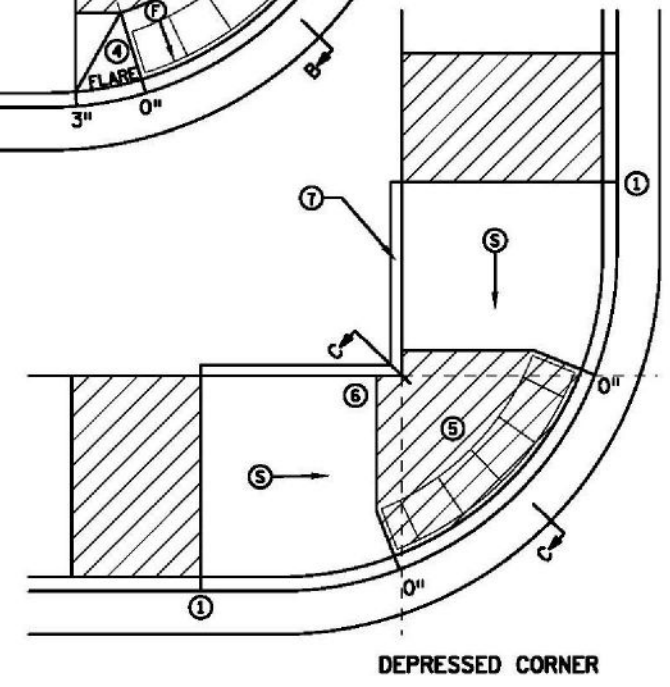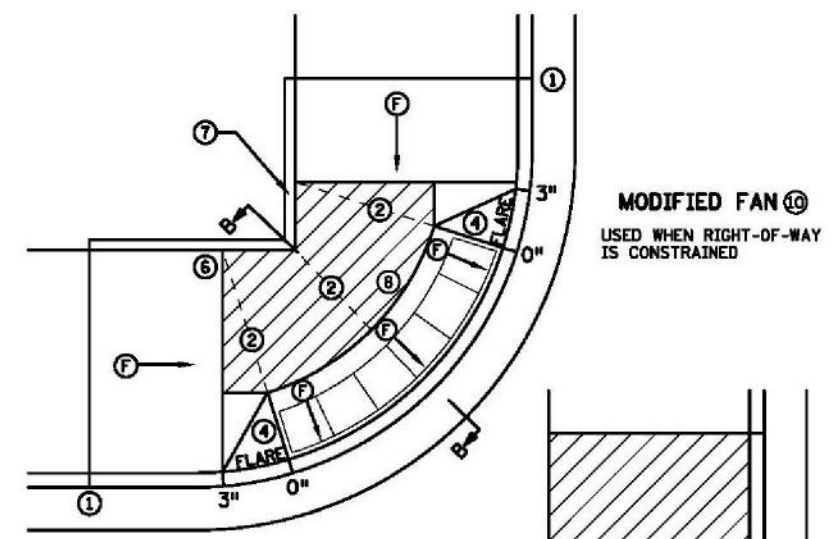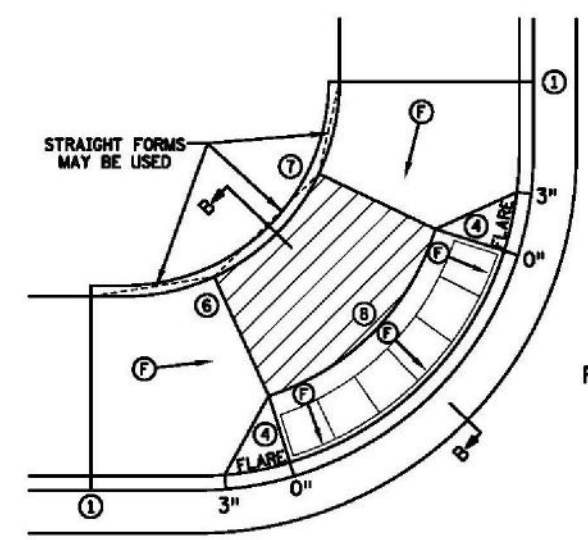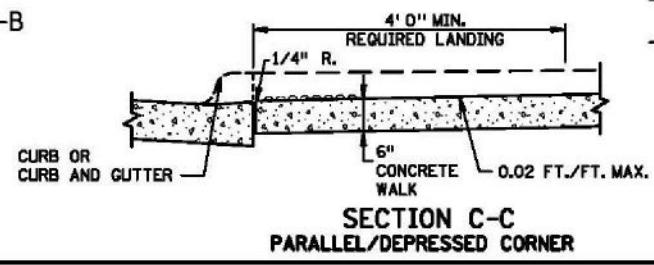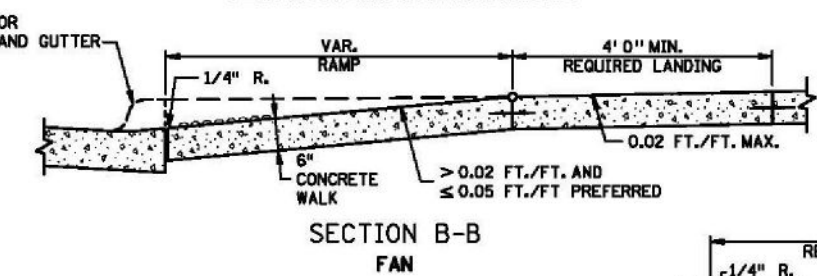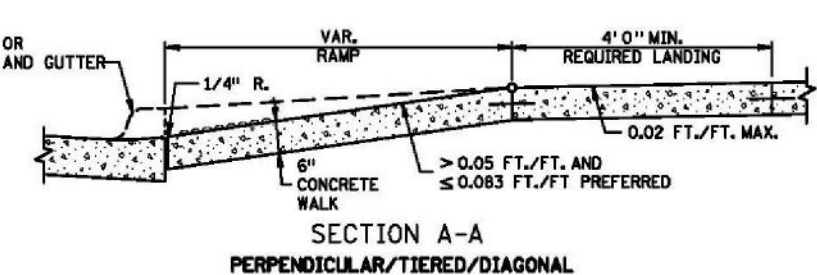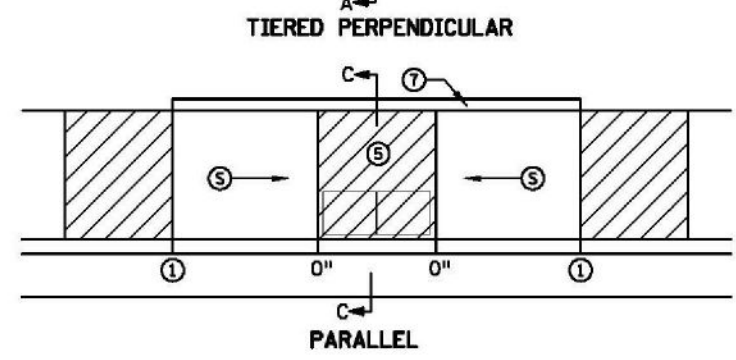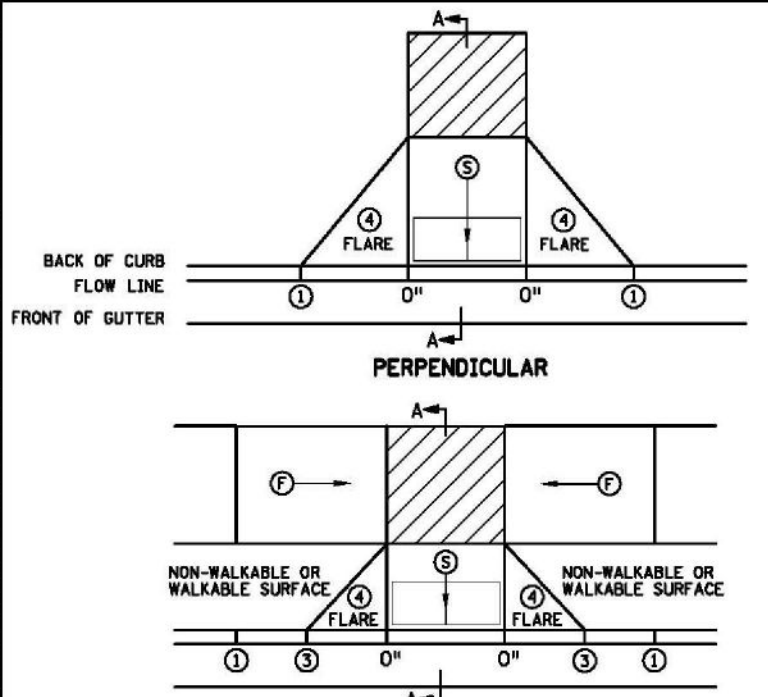

NOTES:

LANDINGS SHALL BE LOCATED ANYWHERE THE PEDESTRIAN ACCESS ROUTE (PAR) CHANGES DIRECTION, AT THE TOP OF RAMPS THAT HAVE RUNNING SLOPES GREATER THAN 5.0%, AND IF THE APPROACHING WALK IS INVERSE GRADE GREATER THAN 2%.

INITIAL CURB RAMP LANDINGS SHALL BE CONSTRUCTED WITHIN 15' FROM THE BACK OF CURB, WITH 6' FROM THE BACK OF CURB BEING THE PREFERRED DISTANCE, ONLY APPLICABLE WHEN THE INITIAL RAMP RUNNING SLOPE IS OVER 5.0%.

SECONDARY CURB RAMP LANDINGS ARE REQUIRED FOR EVERY 30' OF VERTICAL RISE WHEN THE LONGITUDINAL RUNNING SLOPE IS GREATER THAN 5.0%.

CONTRACTION JOINTS SHALL BE CONSTRUCTED ALONG ALL GRADE BREAKS WITHIN THE PAR. 1/4" DEEP VISUAL JOINTS SHALL BE USED AT THE TOPS OF CONCRETE FLARES ADJACENT TO WALKABLE SURFACES.

ALL GRADE BREAKS WITHIN THE PAR SHALL BE PERPENDICULAR TO THE PATH OF TRAVEL, THUS BOTH SIDES OF A SLOPED WALKING SURFACE MUST BE EQUAL LENGTH, EXCEPT AS STATED IN (6) BELOW.

TO ENSURE INITIAL RAMPS AND INITIAL LANDINGS ARE PROPERLY CONSTRUCTED, LANDINGS SHALL BE CAST SEPARATELY, FOLLOW SIDEWALK REINFORCEMENT DETAILS ON SHEET 6 AND THE ADA SPECIAL PROVISIONS - PROSECUTION OF WORK (ADA).

TOP OF CURB SHALL MATCH PROPOSED ADJACENT WALK GRADE.

WHEN THE BOULEVARD IS 4' WIDE OR LESS, THE TOP OF CURB TAPER SHALL MATCH THE RAMP SLOPES TO REDUCE NEGATIVE BOULEVARD SLOPES FROM THE TOP BACK OF CURB TO THE PAR.

ALL RAMP TYPES SHOULD HAVE A MINIMUM 3' LONG RAMP LENGTH.

4' MINIMUM WIDTH OF DETECTABLE WARNING IS REQUIRED FOR ALL RAMPS. DETECTABLE WARNINGS SHALL CONTINUOUSLY EXTEND FOR A MIN. OF 24" IN THE PATH OF TRAVEL. DETECTABLE WARNING TO COVER ENTIRE WIDTH OF SHARED-USE PATHS AND THE ENTIRE PAR WIDTH OF THE WALK. DETECTABLE WARNING SHOULD BE 6" LESS THAN THE PAR/TRAIL WIDTH. ARC LENGTH OF RADIAL DETECTABLE WARNINGS SHOULD NOT BE GREATER THAN 20 FEET.

RECTANGULAR DETECTABLE WARNINGS SHALL BE SETBACK 3" FROM THE BACK OF CURB. RADIAL DETECTABLE WARNINGS SHALL BE SETBACK 3" MINIMUM TO 6" MAXIMUM FROM THE BACK OF CURB.

- ① MATCH FULL HEIGHT CURB.
- ② 4' MINIMUM DEPTH LANDING REQUIRED ACROSS TOP OF RAMP.
- ③ 3" HIGH CURB WHEN USING A 3' LONG RAMP, 4" HIGH CURB WHEN USING A 4' LONG RAMP.
- ④ SEE SHEET 4 OF 6, TYPICAL SIDE TREATMENT OPTIONS, FOR DETAILS ON FLARES AND RETURNED CURBS, WHEN INITIAL LANDING IS AT FULL CURB HEIGHT.
- ⑤ DETECTABLE WARNINGS MAY BE PART OF THE 4' X 4' MIN. LANDING AREA IF IT IS NOT FEASIBLE TO CONSTRUCT THE LANDING OUTSIDE OF THE DETECTABLE WARNING AREA.
- ⑥ THE GRADE BREAK SHALL BE PERPENDICULAR TO THE BACK OF WALK, THIS WILL ENSURE THAT THE GRADE BREAK IS PERPENDICULAR TO THE DIRECTION OF TRAVEL. (TYPICAL FOR ALL)
- ⑦ WHEN ADJACENT TO GRASS, GRADING SHALL ALWAYS BE USED WHEN FEASIBLE. V CURBS, IF USED, SHALL BE PLACED OUTSIDE THE SIDEWALK LIMITS WHEN RIGHT OF WAY ALLOWS. WHEN ADJACENT TO PARKING LOTS, CONCRETE OR BITUMINOUS TAPERS SHOULD BE USED OVER V CURB TO REDUCE TRIPPING HAZARDS AND FACILITATE SNOW & ICE REMOVAL.
- ⑧ A 7' MIN TOP RADIUS GRADE BREAK REQUIRED TO BE CONSTRUCTIBLE.
- ⑨ PAVE FULL WALK WIDTH.
- ⑩ "S" SLOPES ON FANS SHALL ONLY BE USED WHEN ALL OTHER FEASIBLE OPTIONS HAVE BEEN EVALUATED AND DEEMED IMPRACTICAL.

LEGEND	
THESE LONGITUDINAL SLOPE RANGES SHALL BE THE STARTING POINT, IF SITE CONDITIONS WARRANT, LONGITUDINAL SLOPES UP TO 8.3% OR FLATTER ARE ALLOWED.	
(S)	INDICATES PEDESTRIAN RAMP - SLOPE SHALL BE BETWEEN 5.0% MINIMUM AND 8.3% MAXIMUM IN THE DIRECTION SHOWN AND THE CROSS SLOPE SHALL NOT EXCEED 2.0%.
(F)	INDICATES PEDESTRIAN RAMP - SLOPE SHALL BE GREATER THAN 2.0% AND LESS THAN 5.0% IN THE DIRECTION SHOWN AND CROSS SLOPE SHALL NOT EXCEED 2.0%.
(Hatched Box)	LANDING AREA - 4' X 4' MIN. (5' X 5' MIN, PREFERRED) DIMENSIONS AND MAX 2.0% SLOPE IN ALL DIRECTIONS. LANDING SHALL BE FULL WIDTH OF INCOMING PAR.
X"	CURB HEIGHT

REVISION:
APPROVED: JANUARY 23, 2017
OPERATIONS ENGINEER

REVISION: _____
 APPROVED: *Rom S...*
 STATE DESIGN ENGINEER
 1-23-2017

PEDESTRIAN CURB RAMP DETAILS
STANDARD PLAN 5-297.250
1 OF 6

Engineering, Surveying & Planning
JOHNSON & SCOFIELD INC.
 1203 Main Street Red Wing, MN 55066
 ph. 651.388.1558 fax 651.388.1559

I HEREBY CERTIFY THAT THIS PLAN, SPECIFICATION, OR REPORT WAS PREPARED BY ME OR UNDER MY DIRECT SUPERVISION AND I AM A DULY LICENSED PROFESSIONAL ENGINEER UNDER THE LAWS OF THE STATE OF MINNESOTA.
 Steven P. Voigt, PE
 DATE 3-3-2021 REG. NO. 20034


DESIGNED	BY	DATE
SPD\SPV	SPD	3/11/2021
DRAWN	SPD	
CHECKED	SPV	

LATEST REVISION: 3-11-21
 Prepared For:
ANDY BAARTMAN
 A-1 CLEANING
 P.O.B. 31
 RED WING, MN 55066
 PHONE: 651-301-5103


ZUMBROTA APARTMENTS
ZUMBROTA, MN

DETAILS
SHEET 11 OF 29 SHEETS


DISTRICT #: DISTRICT *
 USER NAME: #USER#NAME##
 PATH & FILENAME: Documents/Operations/ADA_Review/ADA_Design/Details/Standard/Operations/Details/Details/curb&space&Ramp&space&Standard&space&Sid&space&Ssp
 FILE NAME: @FILENAME@

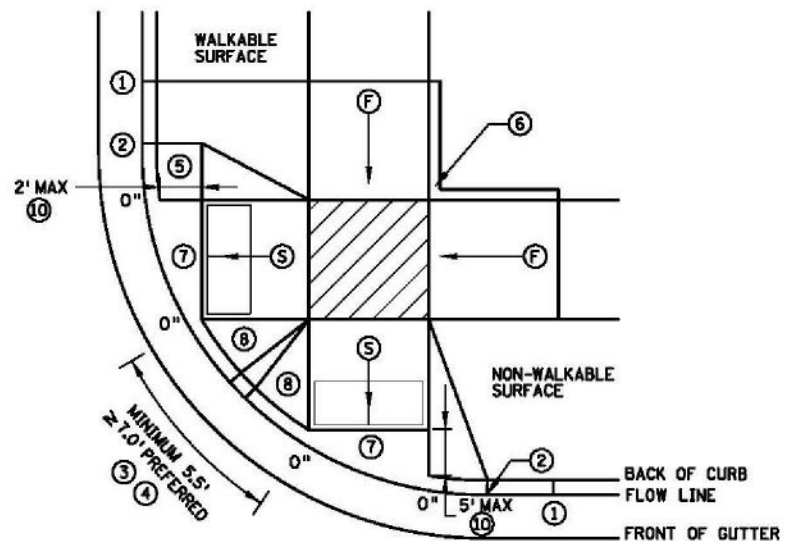


COMBINED DIRECTIONAL ⑨

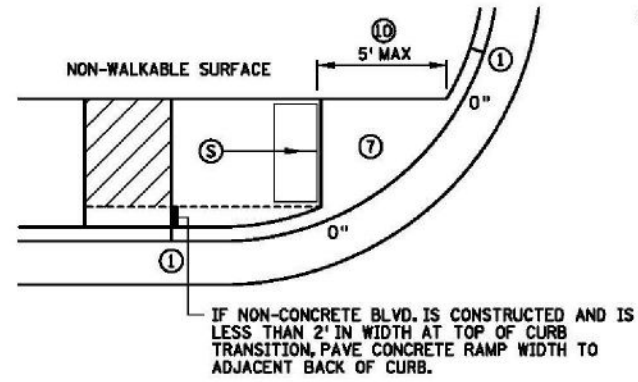


STANDARD ONE-WAY DIRECTIONAL ⑩

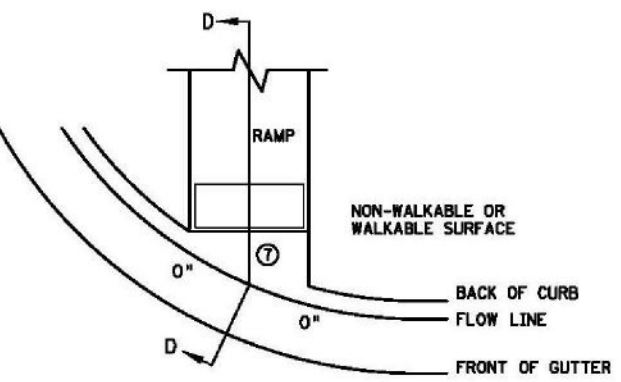



CURB FOR DIRECTIONAL RAMPS ⑭

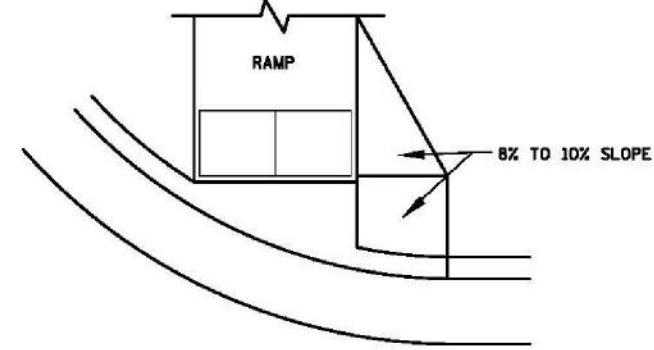


DIRECTIONAL RAMP WALKABLE FLARE

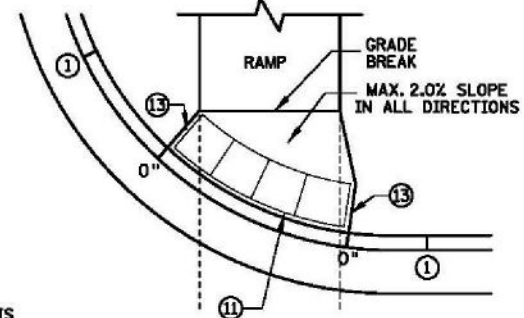

ONE-WAY DIRECTIONAL WITH DETECTABLE WARNING AT BACK OF CURB

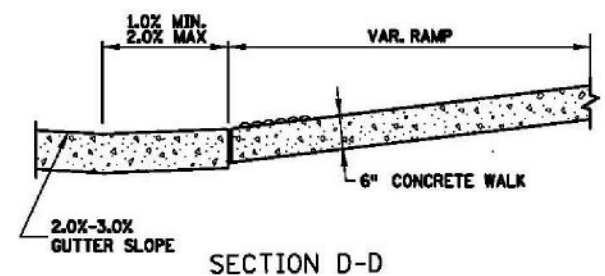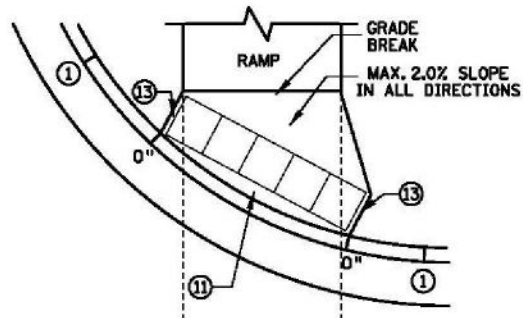

SECTION D-D

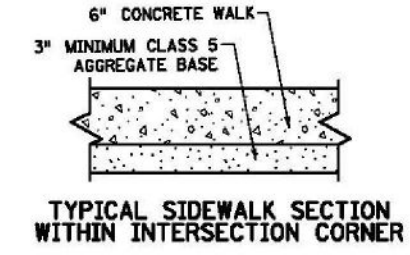

TYPICAL SIDEWALK SECTION WITHIN INTERSECTION CORNER

NOTES:

- LANDINGS SHALL BE LOCATED ANYWHERE THE PEDESTRIAN ACCESS ROUTE (PAR) CHANGES DIRECTION, AT THE TOP OF RAMPS THAT HAVE RUNNING SLOPES GREATER THAN 5.0%, AND IF THE APPROACHING WALK IS INVERSE GRADE.
- INITIAL CURB RAMP LANDINGS SHALL BE CONSTRUCTED WITHIN 15' FROM THE BACK OF CURB, WITH 6' FROM THE BACK OF CURB BEING THE PREFERRED DISTANCE, ONLY APPLICABLE WHEN THE INITIAL RAMP RUNNING SLOPE IS OVER 5.0%.
- SECONDARY CURB RAMP LANDINGS ARE REQUIRED FOR EVERY 30" OF VERTICAL RISE WHEN THE LONGITUDINAL SLOPE IS GREATER THAN 5.0%.
- CONTRACTION JOINTS SHALL BE CONSTRUCTED ALONG ALL GRADE BREAKS WITHIN THE PAR. 1/4" DEEP VISUAL JOINTS SHALL BE USED AT THE TOP GRADE BREAK OF CONCRETE FLARES ADJACENT TO WALKABLE SURFACES.
- ALL GRADE BREAKS WITHIN THE PAR SHALL BE PERPENDICULAR TO THE PATH OF TRAVEL. THUS BOTH SIDES OF A SLOPED WALKING SURFACE MUST BE EQUAL LENGTH.
- TO ENSURE INITIAL RAMPS AND INITIAL LANDINGS ARE PROPERLY CONSTRUCTED, LANDINGS SHALL BE CAST SEPARATELY, FOLLOW SIDEWALK REINFORCEMENT DETAILS ON SHEET 6 AND THE ADA SPECIAL PROVISION (PROSECUTION OF WORK).
- TOP OF CURB SHALL MATCH PROPOSED ADJACENT WALK GRADE.
- WHEN THE BOULEVARD IS 4' WIDE OR LESS, THE TOP OF CURB TAPER SHALL MATCH THE RAMP SLOPES TO REDUCE NEGATIVE BOULEVARD SLOPES FROM THE TOP BACK OF CURB TO THE PAR.
- ALL RAMP TYPES SHOULD HAVE A MINIMUM 3' LONG RAMP LENGTH.
- 4' MINIMUM WIDTH OF DETECTABLE WARNING IS REQUIRED FOR ALL RAMPS. DETECTABLE WARNINGS SHALL CONTINUOUSLY EXTEND FOR A MIN. OF 24" IN THE PATH OF TRAVEL. DETECTABLE WARNING TO COVER ENTIRE WIDTH OF SHARED-USE PATH AND THE ENTIRE PAR WIDTH OF THE WALK. DETECTABLE WARNING SHOULD BE 6" LESS THAN THE PAR/PATH WIDTH. ARC LENGTH OF RADIAL DETECTABLE WARNINGS SHOULD NOT BE GREATER THAN 20 FEET.
- RADIAL DETECTABLE WARNINGS SHALL BE SETBACK 3" MINIMUM TO 6" MAXIMUM FROM THE BACK OF CURB. SEE NOTES ⑩ & ⑪ FOR INFORMATION REGARDING RECTANGULAR DETECTABLE WARNING PLACEMENT.
- ① MATCH FULL CURB HEIGHT.
- ② 3" HIGH CURB WHEN USING A 3' LONG RAMP
4" HIGH CURB WHEN USING A 4' LONG RAMP.
- ③ 3" MINIMUM CURB HEIGHT (5.5' MIN. DISTANCE REQUIRED BETWEEN DOMES)
4" PREFERRED (7' MIN. DISTANCE REQUIRED BETWEEN DOMES).
- ④ THE "BUMP" IN BETWEEN THE RAMPS SHOULD NOT BE IN THE PATH OF TRAVEL FOR COMBINED DIRECTIONAL RAMPS. IF THIS OCCURS MODIFY THE RAMP LOCATION OR SWITCH RAMP TO A FAN/DEPRESSED CORNER.
- ⑤ WHEN USING CONCRETE PAVED FLARES ON THE OUTSIDE OF DIRECTIONAL RAMPS, AND ADJACENT TO A WALKABLE SURFACE, DIRECTIONAL RAMP FLARES SHOULD BE USED. SEE THE DETAIL ON THIS SHEET.
- ⑥ GRADING SHALL ALWAYS BE USED WHEN FEASIBLE. V CURB, IF USED, SHALL BE PLACED OUTSIDE THE SIDEWALK LIMITS WHEN RIGHT OF WAY ALLOWS. WHEN ADJACENT TO PARKING LOTS, CONCRETE OR BITUMINOUS TAPERS SHOULD BE USED OVER V CURB TO REDUCE TRIPPING HAZARDS AND FACILITATE SNOW & ICE REMOVAL.
- ⑦ MAX. 2.0% SLOPE IN ALL DIRECTIONS IN FRONT OF GRADE BREAK AND DRAIN TO FLOW LINE. SHALL BE CONSTRUCTED INTEGRAL WITH CURB AND GUTTER.
- ⑧ 8% TO 10% WALKABLE FLARE.
- ⑨ PLACE DOMES AT THE BACK OF CURB WHEN ALLOWABLE SETBACK CRITERIA IS EXCEEDED.
- ⑩ FRONT EDGE OF DETECTABLE WARNING SHALL BE SET BACK 2' MAXIMUM WHEN ADJACENT TO WALKABLE SURFACE, AND 5' MAXIMUM WHEN ADJACENT TO NON-WALKABLE SURFACE WITH ONE CORNER SET 3" FROM BACK OF CURB. A WALKABLE SURFACE IS DEFINED AS A PAVED SURFACE ADJACENT TO A CURB RAMP WITHOUT RAISED OBSTACLES THAT COULD MISTAKENLY BE TRAVERSED BY A USER WHO IS VISUALLY IMPAIRED.
- ⑪ RECTANGULAR DETECTABLE WARNINGS MAY BE SETBACK UP TO 9" FROM THE BACK OF CURB WITH CORNERS SET 3" FROM BACK OF CURB. IF 9" SETBACK IS EXCEEDED USE RADIAL DETECTABLE WARNINGS.
- ⑫ FOR DIRECTIONAL RAMPS WITH THE DETECTABLE WARNINGS PLACED AT THE BACK OF CURB, THE DETECTABLE WARNINGS SHALL COVER THE ENTIRE WIDTH OF THE WALK/PATH. THIS ENSURES A DETECTABLE EDGE AND HELPS ELIMINATE THE CURB TAPER OBSTRUCTING THE PATH OF PEDESTRIAN TRAVEL.
- ⑬ THE CONCRETE WALK SHALL BE FORMED AND CONSTRUCTED PERPENDICULAR TO THE BACK OF CURB. MAINTAIN 3" BETWEEN EDGE OF DOMES AND EDGE OF CONCRETE.
- ⑭ TO BE USED FOR ALL DIRECTIONAL RAMPS, EXCEPT WHERE DOMES ARE PLACED ALONG THE BACK OF CURB.

LEGEND

THESE LONGITUDINAL SLOPE RANGES SHALL BE THE STARTING POINT. IF SITE CONDITIONS WARRANT, LONGITUDINAL SLOPES UP TO 8.3% OR FLATTER ARE ALLOWED.

- ⑤ INDICATES PEDESTRIAN RAMP - SLOPE SHALL BE BETWEEN 5.0% MINIMUM AND 8.3% MAXIMUM IN THE DIRECTION SHOWN AND THE CROSS SLOPE SHALL NOT EXCEED 2.0%.
- ⑥ INDICATES PEDESTRIAN RAMP - SLOPE SHALL BE GREATER THAN 2.0% AND LESS THAN 5.0% IN THE DIRECTION SHOWN AND CROSS SLOPE SHALL NOT EXCEED 2.0%.
- ⑦ LANDING AREA - 4' X 4' MIN. (5' X 5' MIN. PREFERRED) DIMENSIONS AND MAX 2.0% SLOPE IN ALL DIRECTIONS. LANDING SHALL BE FULL WIDTH OF INCOMING PAR.
- X" CURB HEIGHT

REVISION:
APPROVED: JANUARY 23, 2017
<i>[Signature]</i> OPERATIONS ENGINEER

REVISION: _____
 APPROVED: *[Signature]*
 STATE DESIGN ENGINEER
 1-23-2017

PEDESTRIAN CURB RAMP DETAILS
 STANDARD PLAN 5-297.250 2 OF 6

Engineering, Surveying & Planning
JOHNSON & SCOFIELD INC.
 1203 Main Street Red Wing, MN 55066
 ph. 651.388.1558 fax 651.388.1559





I HEREBY CERTIFY THAT THIS PLAN, SPECIFICATION, OR REPORT WAS PREPARED BY ME OR UNDER MY DIRECT SUPERVISION AND I AM A DULY LICENSED PROFESSIONAL ENGINEER UNDER THE LAWS OF THE STATE OF MINNESOTA.
[Signature]
 Steven P. Volgt, PE
 DATE 3-3-2021 REG. NO. 20034

DESIGNED	SPD\SPV	REVISION	ADDENDUM #2	BY	SPD	DATE	3/11/2021
DRAWN	SPD						
CHECKED	SPV						

LATEST REVISION: 3-11-21
 Prepared For:
 ANDY BAARTMAN
 A-1 CLEANING
 P.O.B. 31
 RED WING, MN 55066
 PHONE: 651-301-5103

ZUMBROTA APARTMENTS
ZUMBROTA, MN
DETAILS
 SHEET 12 OF 29 SHEETS

DISTRICT #: DISTRICT *
 USER NAME: \$\$\$USER\$NAME\$\$\$
 PATH & FILENAME: Documents\Operations\ADA_Review\ADA_DesignGuidelines\AD&space;Standard&space;Detail&space;Plates\2016&space;Cur&space;Ramp&space;Space;ST&space;

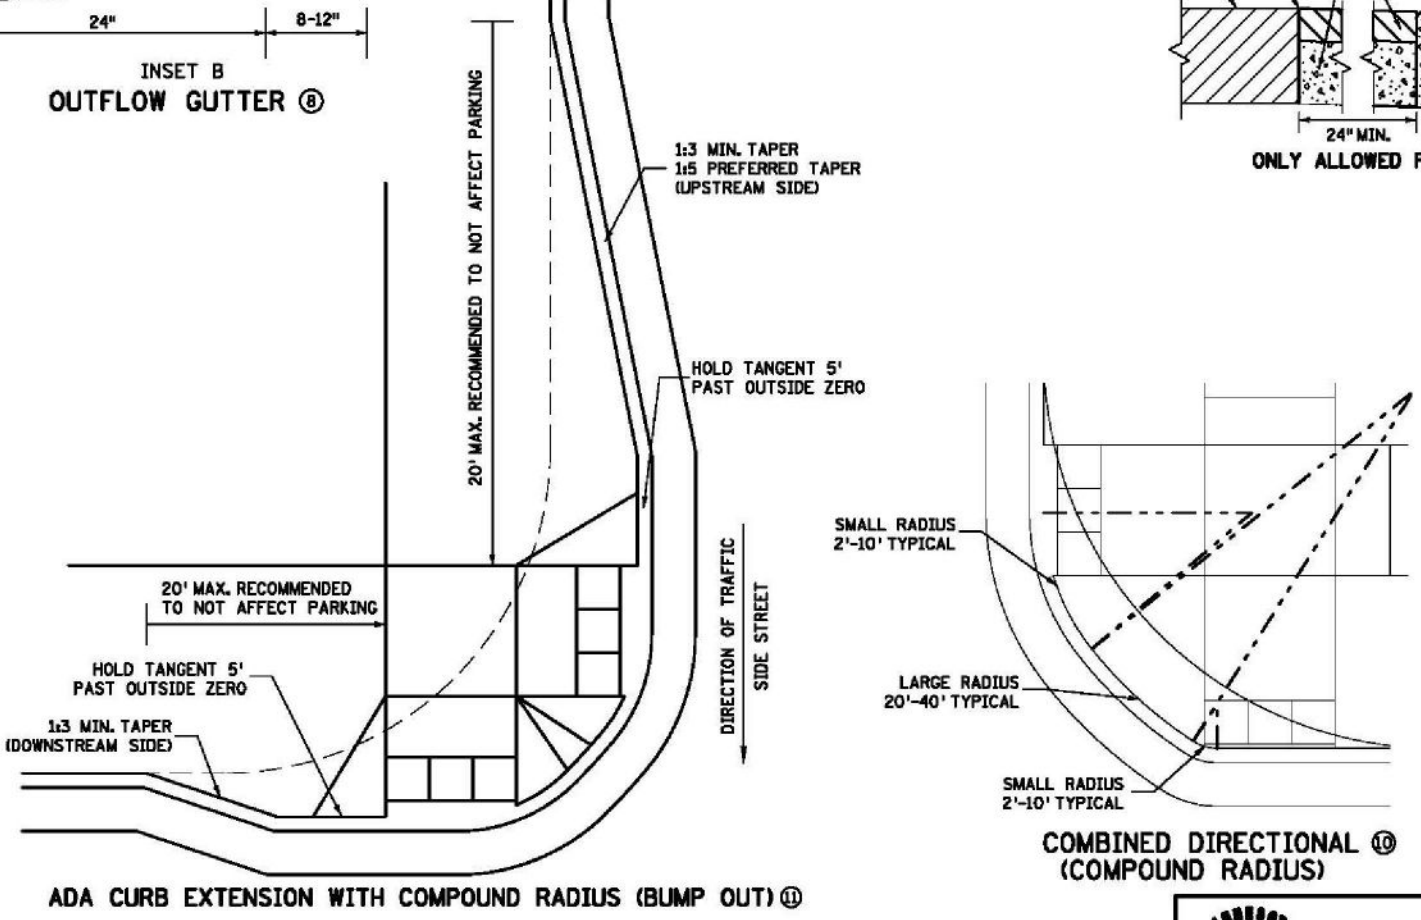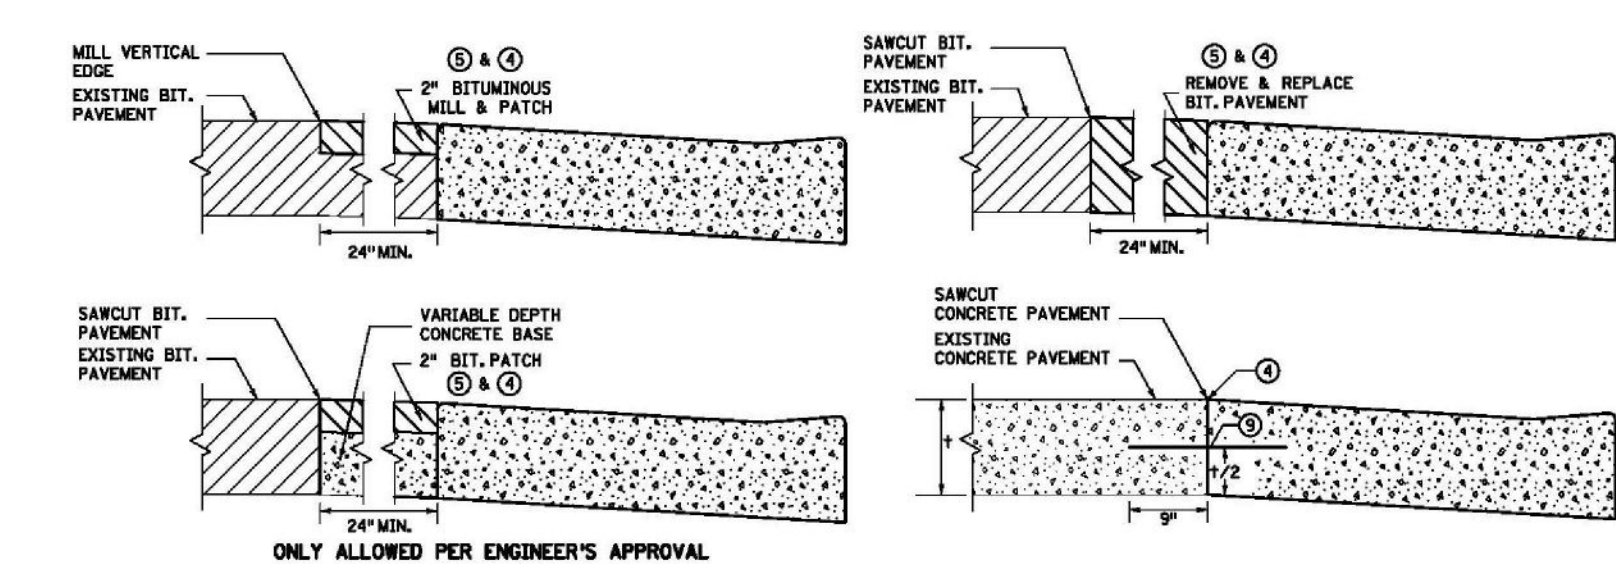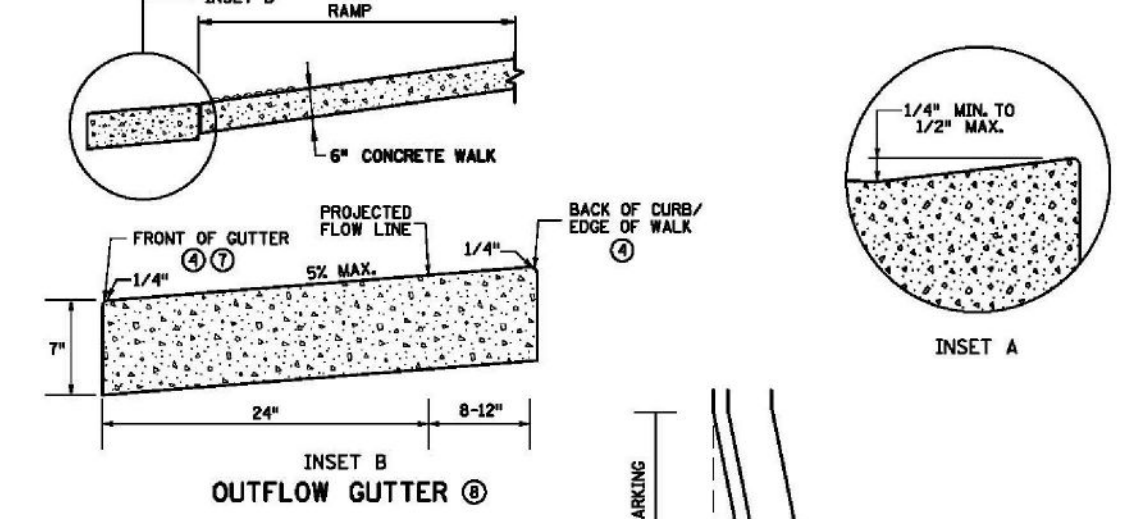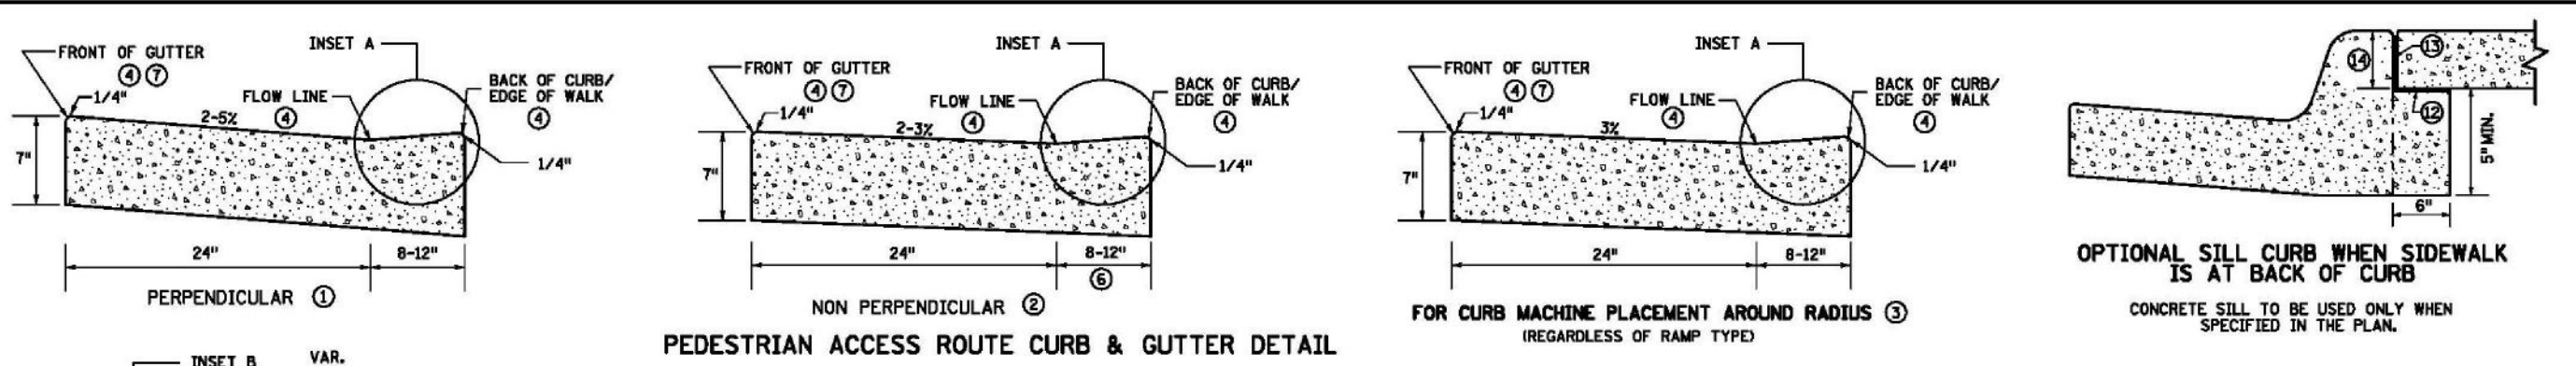

- NOTES:**
- POSITIVE FLOW LINE DRAINAGE SHALL BE MAINTAINED THROUGH THE PEDESTRIAN ACCESS ROUTE (PAR) AT A 2% MAXIMUM. NO PONDING SHALL BE PRESENT IN THE PAR.
 - ANY VERTICAL LIP THAT OCCURS AT THE FLOW LINE SHALL NOT BE GREATER THAN 1/4 INCH.
 - ① FOR USE AT CURB CUTS WHERE THE PEDESTRIAN'S PATH OF TRAVEL IS ASSUMED PERPENDICULAR TO THE GUTTER FLOW LINE. RAMP TYPES INCLUDE: PERPENDICULAR, TIERED PERPENDICULAR, PARALLEL, AND DIAGONAL RAMPS.
 - ② FOR USE AT CURB RAMPS WHERE THE PEDESTRIAN'S PATH OF TRAVEL IS ASSUMED NON PERPENDICULAR TO THE GUTTER FLOW LINE. RAMP TYPES INCLUDE: FANS & DEPRESSED CORNERS.
 - ③ BEGIN GUTTER SLOPE TRANSITION 10' OUTSIDE OF ALL CURB RAMPS.
 - ④ THERE SHALL BE NO VERTICAL DISCONTINUITIES GREATER THAN 1/4\".
 - ⑤ ELEVATION CHANGE TAKES PLACE FROM THE EXISTING TO NEW FRONT OF GUTTER. PATCH IS USED TO MATCH THE NEW GUTTER FACE INTO THE EXISTING ROADWAY.
 - ⑥ VARIABLE WIDTH FOR DIRECTIONAL CURB APPLICATIONS. SEE SHEET 2 FOR DIRECTIONAL CURB SLOPE REQUIREMENTS.
 - ⑦ TOP FRONT OF GUTTER SHALL BE CONSTRUCTED FLUSH WITH PROPOSED ADJACENT PAVEMENT ELEVATION. TOP 1.5\" OF THE GUTTER FACE MUST BE A FORMED EDGE. PAR GUTTER SHALL NOT BE OVERLAID.
 - ⑧ SHOULD BE USED AT VERTICALLY CONSTRAINED AREAS WHEN AT A DRAINAGE HIGH POINT OR SUPER ELEVATED ROADWAY SEGMENTS.
 - ⑨ DRILL AND GROUT NO. 4 EPOXY-COATED 18\" LONG TIE BARS AT 30\" CENTER TO CENTER INTO EXISTING CONCRETE PAVEMENT 1\" MINIMUM FROM ALL JOINTS.
 - ⑩ HELPS PROVIDE TWO SEPARATE RAMPS, REDUCES THE DOME SETBACK LENGTH AND MINIMIZES DIRECTIONAL CURB. THIS RADIUS DESIGN CLOSELY FOLLOWS THE TURNING VEHICLE PATH WHILE OPTIMIZING CURB RAMP LENGTH.
 - ⑪ CURB EXTENSIONS SHOULD BE USED IN VERTICALLY CONSTRAINED AREAS, USUALLY IN DOWNTOWN ROADWAY SEGMENTS WHERE ON-STREET PARKING IS AVAILABLE. CURB EXTENSIONS SHOULD BE CONSIDERED FOR APS INTERSECTIONS WHERE SPACE IS LIMITED. PUSH BUTTONS MUST MEET APS CRITERIA AS DESCRIBED IN THE PUSH BUTTON LOCATION DETAIL SHEET.
 - ⑫ PLACE BOND BREAKER BETWEEN WALK AND TOP OF SILL.
 - ⑬ 1/2\" PREFORMED JOINT FILLER PER MNDOT SPEC. 3702.
 - ⑭ DIMENSION TO BE SAME AS SIDEWALK THICKNESS, 4\" MIN.

REVISION:
 APPROVED: JANUARY 23, 2017
 OPERATIONS ENGINEER

 STATE DESIGN ENGINEER	APPROVED: 1-23-2017	PEDESTRIAN CURB RAMP DETAILS	
	STANDARD PLAN 5-297.250		3 OF 6


Engineering, Surveying & Planning
JOHNSON & SCOFIELD INC.
 1203 Main Street Red Wing, MN 55066
 ph. 651.388.1558 fax 651.388.1559

I HEREBY CERTIFY THAT THIS PLAN, SPECIFICATION, OR REPORT WAS PREPARED BY ME OR UNDER MY DIRECT SUPERVISION AND I AM A DULY LICENSED PROFESSIONAL ENGINEER UNDER THE LAWS OF THE STATE OF MINNESOTA.
 Steven P. Voigt, PE
 DATE 3-3-2021 REG. NO. 20034


DESIGNED	BY	DATE
SPD\SPV	SPD	3/11/2021
DRAWN	SPD	
CHECKED	SPV	

LATEST REVISION: 3-11-21
 Prepared For:
 ANDY BAARTMAN
 A-1 CLEANING
 P.O.B. 31
 RED WING, MN 55066
 PHONE: 651-301-5103


ZUMBROTA APARTMENTS
ZUMBROTA, MN
DETAILS
SHEET 13 OF 29 SHEETS

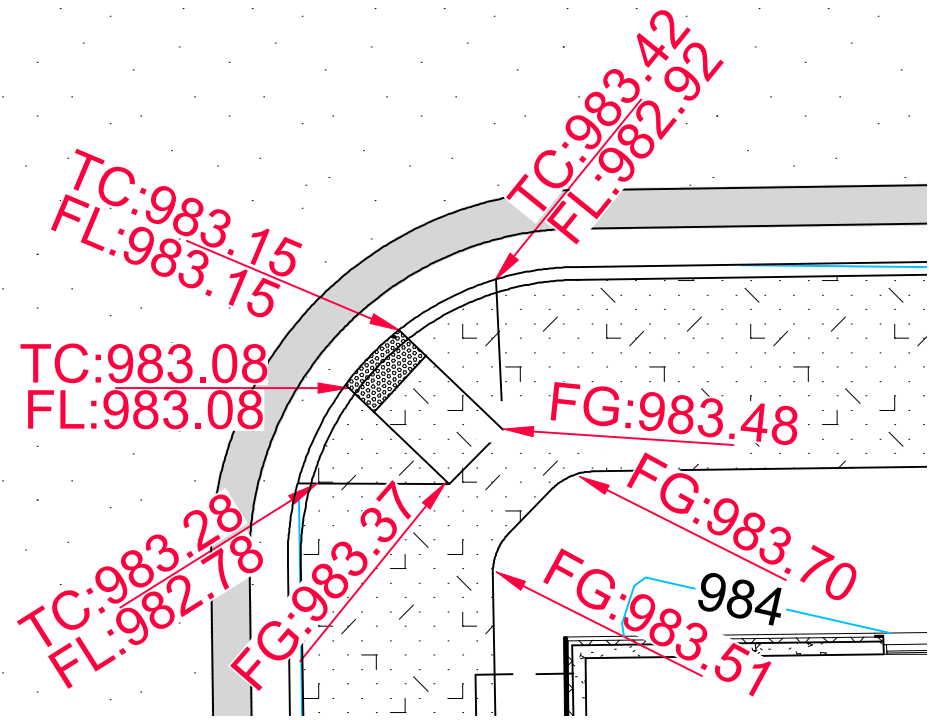


PEDESTRIAN CURB RAMP 1

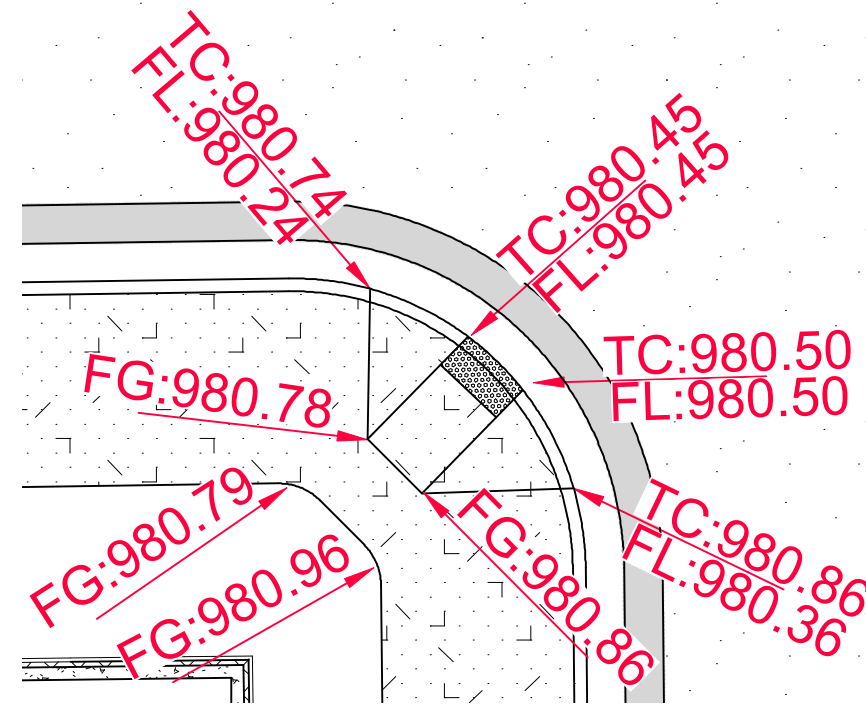


PEDESTRIAN CURB RAMP 2

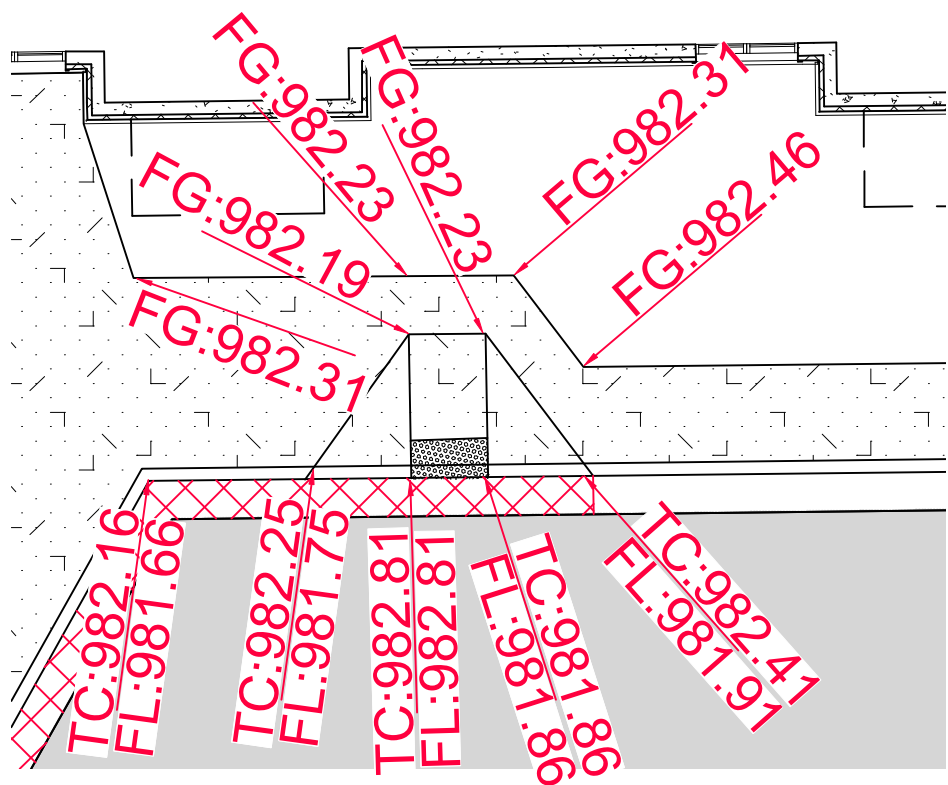

PEDESTRIAN CURB RAMP 3

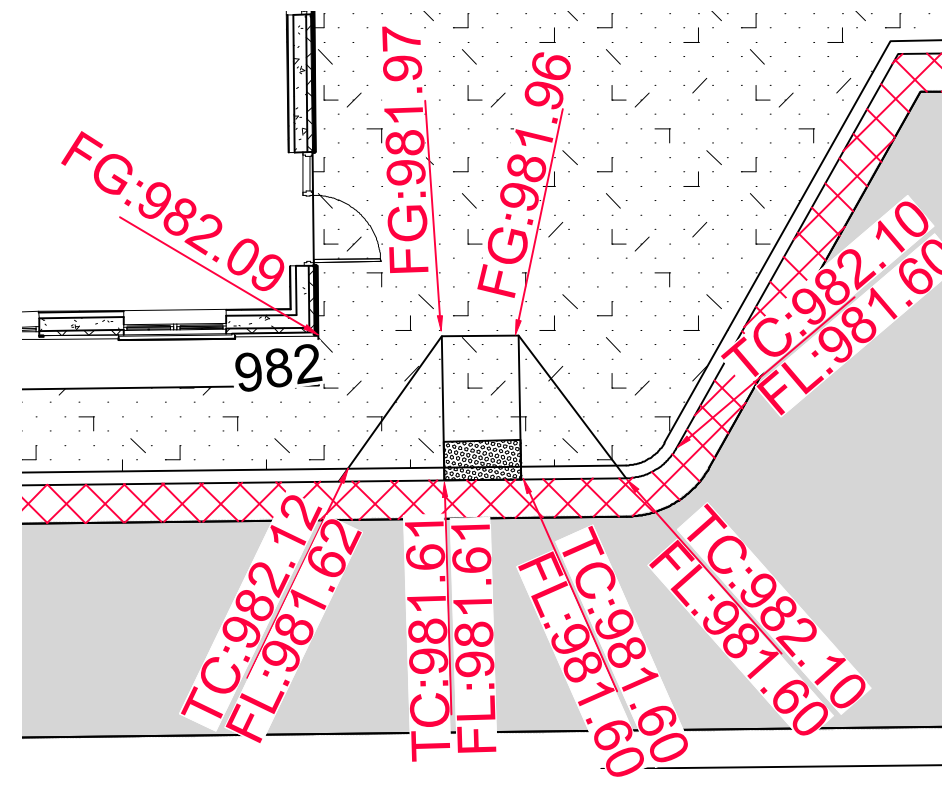

PEDESTRIAN CURB RAMP 4

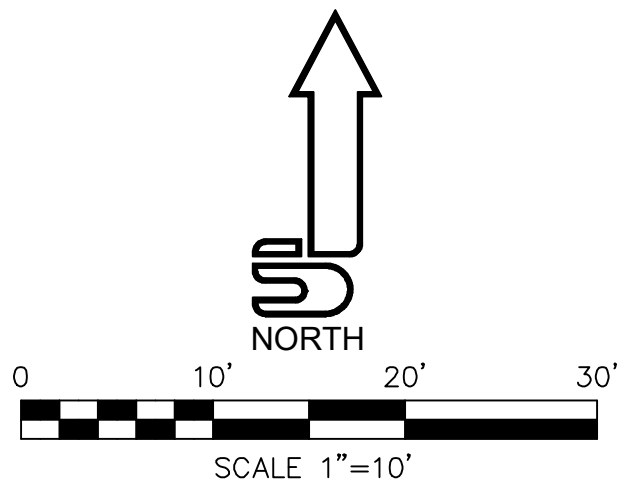

Engineering, Surveying & Planning
JOHNSON & SCOFIELD INC.
 1203 Main Street Red Wing, MN 55066
 ph. 651.388.1558 fax 651.388.1559

I HEREBY CERTIFY THAT THIS PLAN, SPECIFICATION, OR REPORT WAS PREPARED BY ME OR UNDER MY DIRECT SUPERVISION AND I AM A DULY LICENSED PROFESSIONAL ENGINEER UNDER THE LAWS OF THE STATE OF MINNESOTA.
 Steven P. Voigt, PE
 DATE 3-3-2021 REG. NO. 20034

DESIGNED	SPD\SPV
DRAWN	SPD
CHECKED	SPV

REVISED	BY	DATE
ADDENDUM #2	SPD	3/11/2021

LATEST REVISION:3-11-21
 Prepared For:
 ANDY BAARTMAN
 A-1 CLEANING
 P.O.B. 31
 RED WING, MN 55066
 PHONE: 651-301-5103


ZUMBROTA APARTMENTS
 ZUMBROTA, MN

DETAILS
 SHEET 17 OF 29 SHEETS


PLOTTED/REVISED:

DISTRICT * USER NAME: \$\$\$USER\$NAME\$\$\$


FILE NAME: @FILENAME@

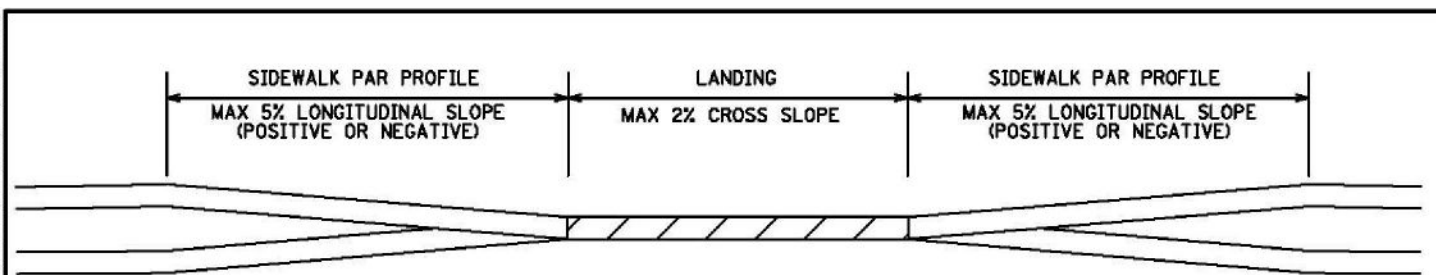


SECTION VIEW B-B

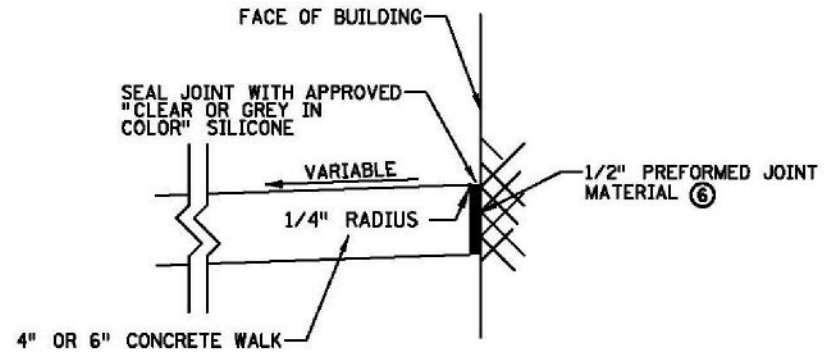


BUILDING JOINT SEAL (INCIDENTAL)

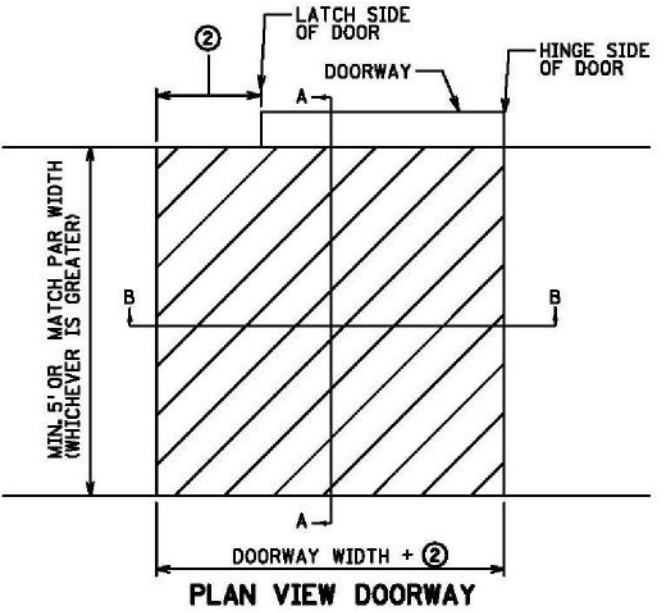


PLAN VIEW DOORWAY

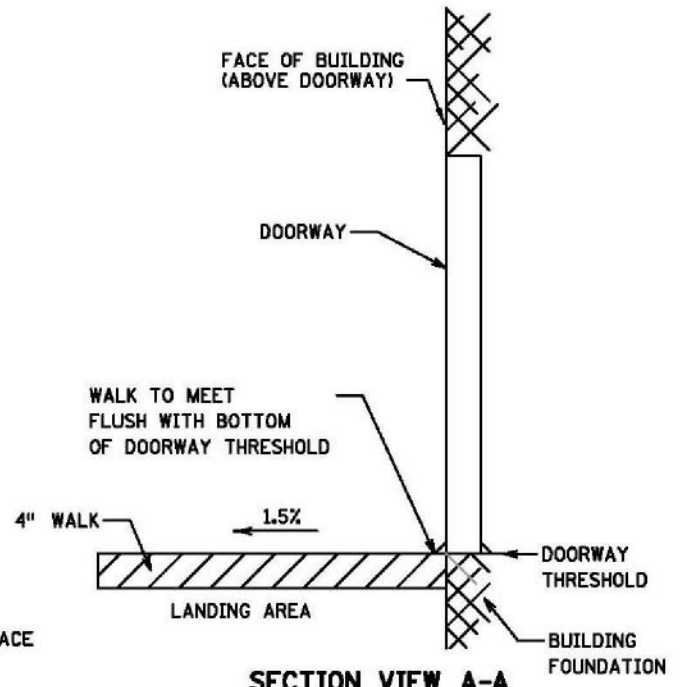

SECTION VIEW A-A

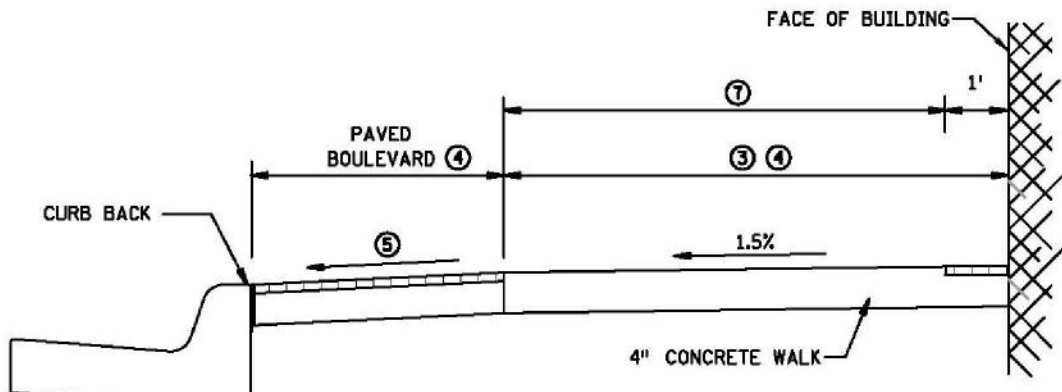

DOWNTOWN SIDEWALK TYPICAL SECTION

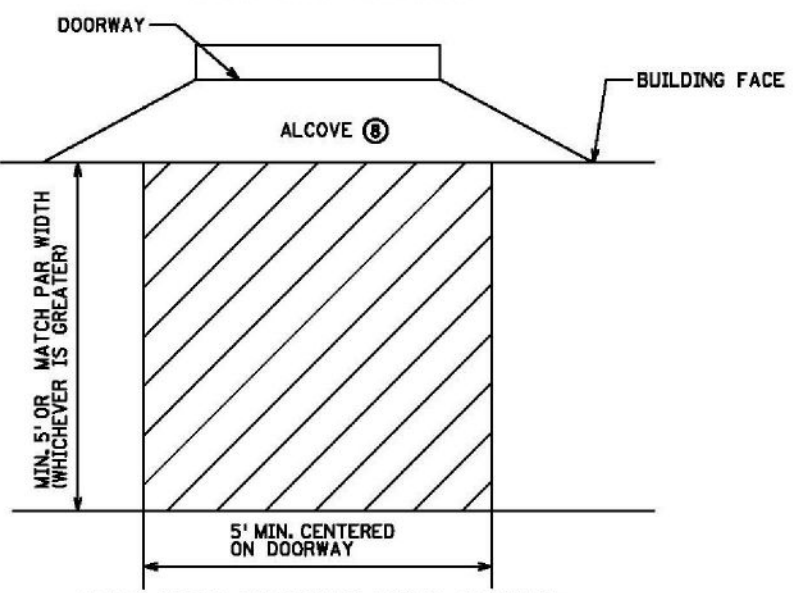

PLAN VIEW DOORWAY WITH ALCOVE
SIDEWALK LANDING REQUIREMENTS 1

NOTES:

- FIELD ADJUST SIDEWALK PROFILES TO MEET ALL DOORWAY THRESHOLDS.
- SIDEWALK MUST MAINTAIN POSITIVE DRAINAGE AWAY FROM THE BUILDING TO THE ROADWAY. SEE SPECIAL PROVISIONS FOR SILICONE SPECIFICATIONS.
- 1 LANDING CRITERIA IS REQUIRED FOR ALL DOORS, PRIVATE WALKS AND STEPS.
- 2 18" MIN. WHEN DOOR SWINGS OUTWARD FROM BUILDING.
12" MIN WHEN DOOR SWINGS INWARD FROM BUILDING.
- 3 6' MIN. PAR REQUIRED WHEN ADJACENT TO BUILDINGS.
- 4 2/3 PAR TO 1/3 BOULEVARD SHOULD BE USED WHEN FEASIBLE.
- 5 1%-5% FOR THE MAJORITY OF THE BLOCK, WITH EXCEPTIONS UP TO 8% IN CONSTRAINED AREAS. 10% MAX. FOR SHORT SECTIONS ALLOWED TO ACCOUNT FOR FIELD TOLERANCES.
- 6 FURNISH AND INSTALL BACKER ROD OF APPROPRIATE DIAMETER.
- 7 TO MINIMIZE VIBRATION AND ROLLING RESISTANCE, AREA SHOULD BE FREE OF PAVERS, STAMPED CONCRETE, AND/OR EXCESSIVE JOINTING.
- 8 2% MAX. PER BUILDING CODE. IF GREATER THAN 2%, FLATTEN AS FEASIBLE.

LEGEND	
	LANDING - ALL SLOPES TO BE LESS THAN 2%
	OPTIONAL AESTHETIC TREATMENT

REVISION
APPROVED: JANUARY 23, 2017

 STATE DESIGN ENGINEER	REVISION APPROVED: 1-23-2017	DRIVEWAY AND SIDEWALK DETAILS	
	STANDARD PLAN 5-297.254	4 OF 4	

Engineering, Surveying & Planning
JOHNSON & SCOFIELD INC.
 1203 Main Street Red Wing, MN 55066
 ph. 651.388.1558 fax 651.388.1559


I HEREBY CERTIFY THAT THIS PLAN, SPECIFICATION, OR REPORT WAS PREPARED BY ME OR UNDER MY DIRECT SUPERVISION AND I AM A DULY LICENSED PROFESSIONAL ENGINEER UNDER THE LAWS OF THE STATE OF MINNESOTA.

 Steven P. Voigt, PE
 DATE 3-3-2021 REG. NO. 20034


DESIGNED	BY	DATE
SPD\SPV	SPD	3/11/2021
DRAWN	SPD	
CHECKED	SPV	

LATEST REVISION: 3-11-21
 Prepared For:
 ANDY BAARTMAN
 A-1 CLEANING
 P.O.B. 31
 RED WING, MN 55066
 PHONE: 651-301-5103


ZUMBROTA APARTMENTS	DETAILS
ZUMBROTA, MN	SHEET 21 OF 29 SHEETS

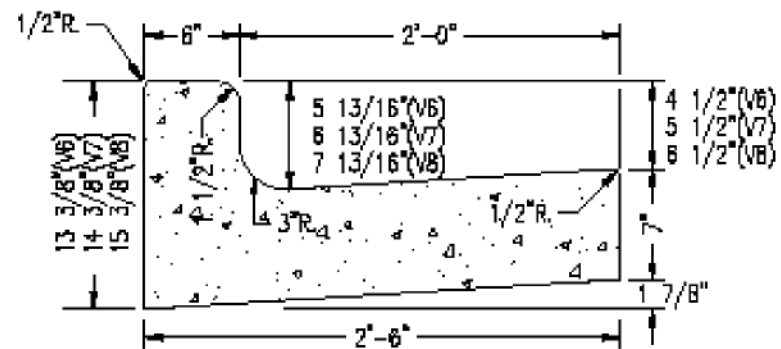

DESIGN "V" (VERTICAL)

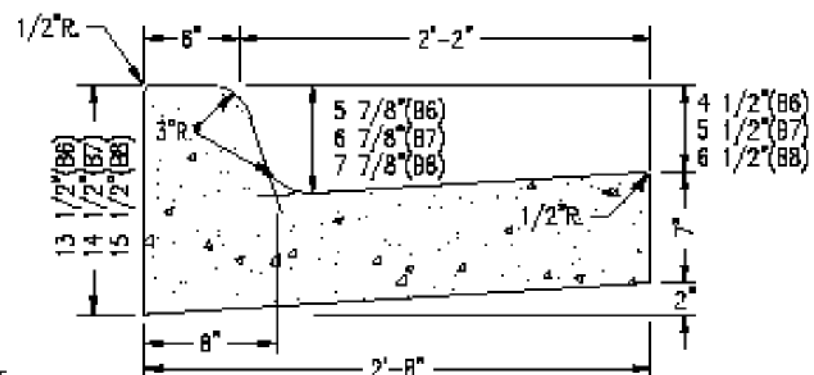


DESIGN "B" (BATTERFACE)

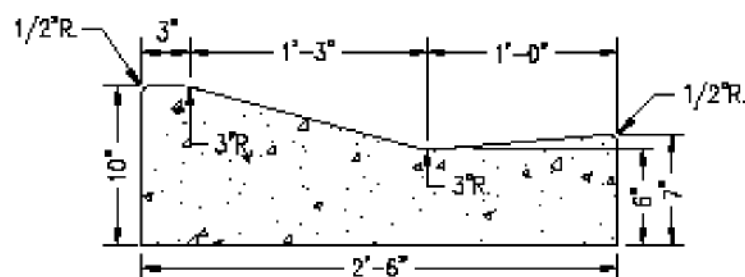


DESIGN "D" (DRIVEOVER)

NOTES

1. CONCRETE MIX: MANUAL PLACEMENT—MN/DOT SPEC. 3F52, SLIP-FORM PLACEMENT—MN/DOT SPEC. 3F32.
2. PROVIDE 1/2" EXPANSION JOINT AT 300' MAXIMUM SPACING AND TO MATCH PAVEMENT EXPANSION JOINTS IN ADDITION TO EXPANSION JOINTS SHOWN ON OTHER DETAIL PLATES. PROVIDE 1/2" PERFORMED JOINT FILLER MATERIAL PER MN/DOT SPEC. 3702.
3. PROVIDE CONTRACTION JOINTS @ 9' MAXIMUM SPACING, SAW CUT 2" MINIMUM DEPTH. TOOLED IN JOINTS SHALL ALSO BE SAW CUT.
4. ALL CONCRETE CURB & GUTTER SHALL BE PLACED ON A MINIMUM OF A 4" AGGREGATE BASE.
5. SILL REQUIRED FOR DESIGN "V" AND "B", WHEREVER SIDEWALK ABUTS CURB. SEE S.D.P. 2-02.
6. RADII OF 25' OR LESS SHALL BE HAND FORMED.

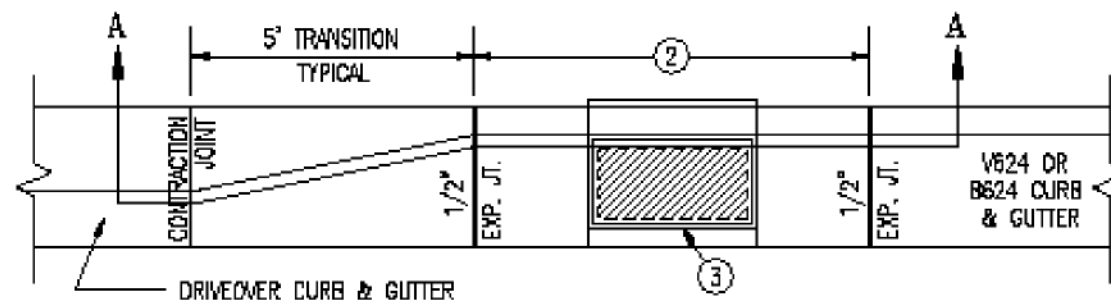


PLAN

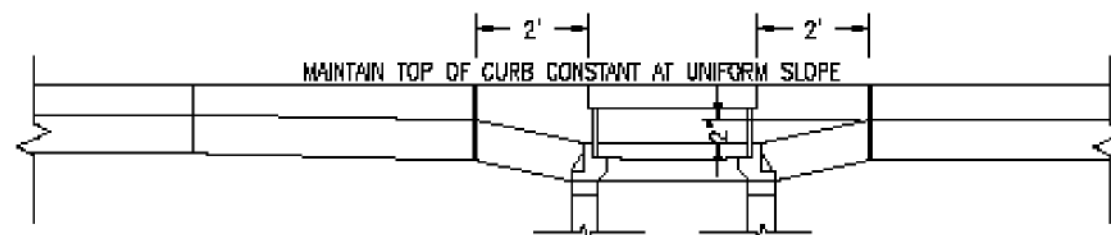

SECTION A-A

NOTES

- ① PROVIDE 1/2" PERFORMED JOINT FILLER MATERIAL PER MN/DOT SPEC. 3702
- ② SEE S.D.P. 2-06 FOR CURB REINFORCEMENT AT CATCH BASIN.
- ③ SEE S.D.P. 1-01 FOR CATCH BASIN DETAIL.

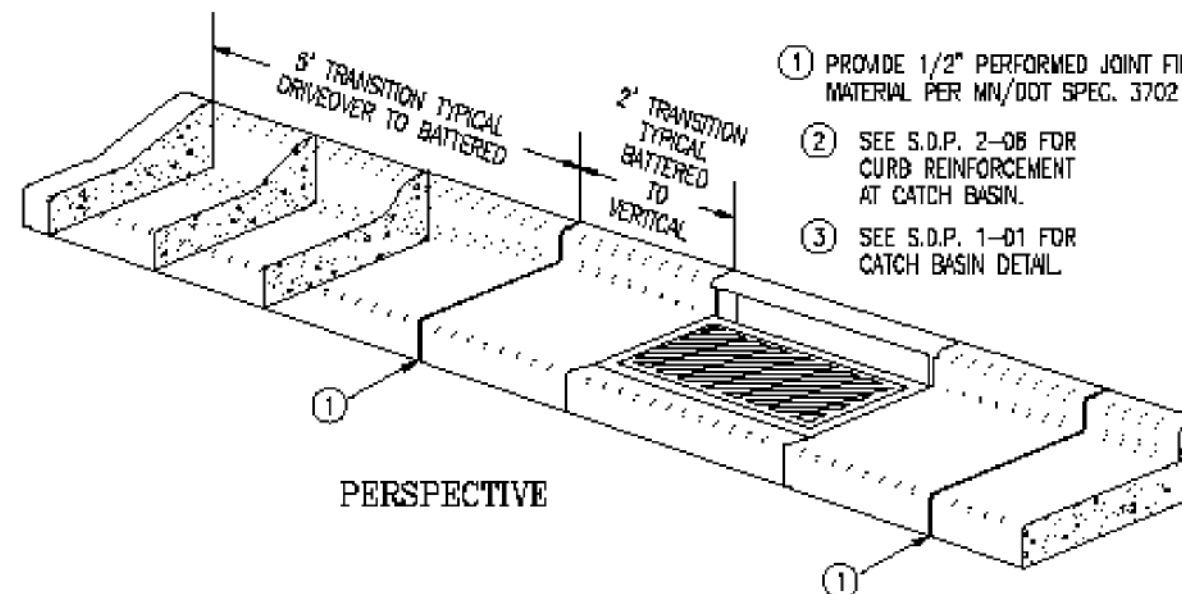

PERSPECTIVE




CONCRETE CURB & GUTTER

REVISED: 12/31/19
SHEET: 1 OF 1
PLATE NO. 2-D1




TRANSITION CURB & GUTTER
DRIVEOVER TO TYPE B OR V

REVISED: 12/31/19
SHEET: 1 OF 1
PLATE NO. 2-05

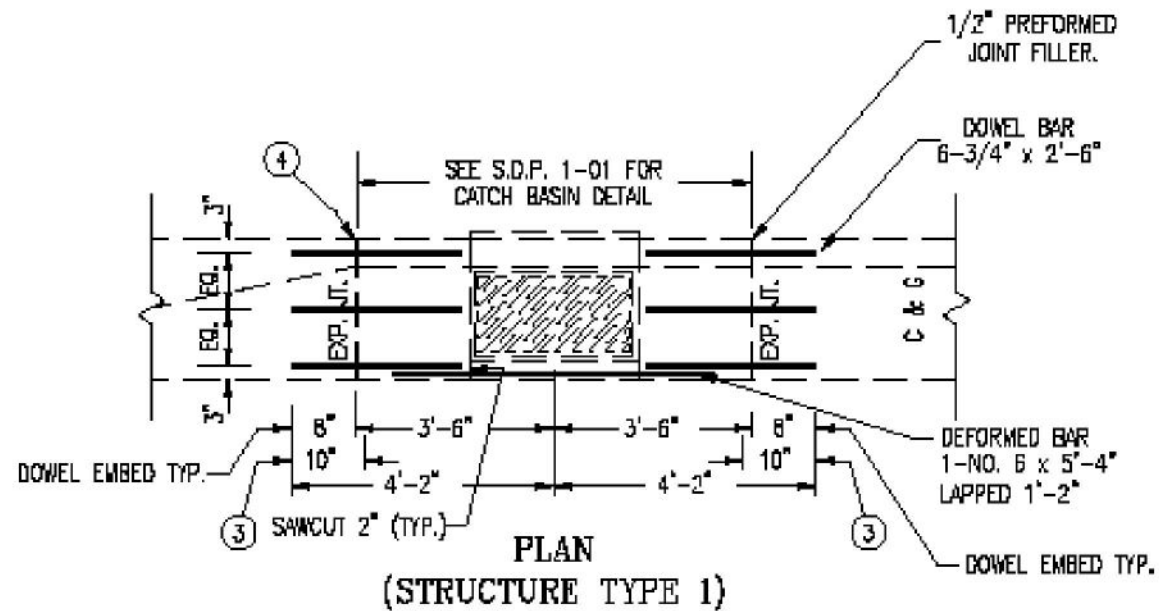

NOTES


1. DOWEL BARS SHALL BE PER MN/DOT SPEC. 3302 (EPOXY COATED).
2. DEFORMED BAR SHALL BE PER MN/DOT SPEC. 3301 (EPOXY COATED).
- ③ COAT THE DOWEL BARS WITH A THIN UNIFORM COATING OF AN APPROVED FORM COATING MATERIAL MEETING MN/DOT SPEC. 3902 NOT MORE THAN THAN ONE HOUR BEFORE COVERING WITH CONCRETE, OR WRAP WITH TEFLON TAPE.
- ④ PROVIDE 1/2" PERFORMED JOINT FILLER MATERIAL PER MN/DOT SPEC. 3702.

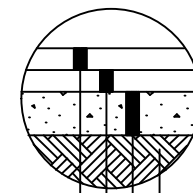

- COMPACTED SUBGRADE
- CONST. 6" CL 5 AGG. BASE
- CONST. 1 1/2" BIT. BASE COURSE - SPNWB330B (MNDOT SPEC. 2360.501)
- CONST. 1 1/2" BIT. WEAR COURSE - SPWEB340B (MNDOT SPEC. 2360.501)

NOT TO SCALE

BITUMINOUS SECTION

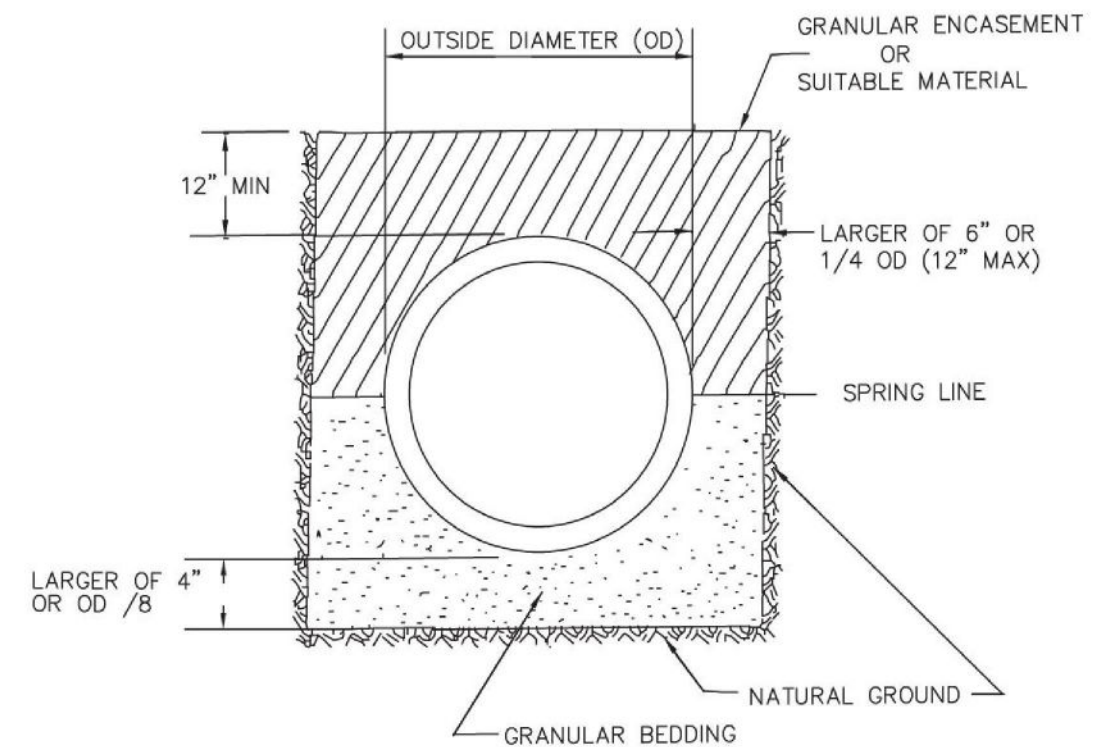


NOT TO SCALE

PIPE BEDDING



**CURB & GUTTER REINFORCEMENT
AT CATCH BASINS**

REVISED:
12/31/19
SHEET:
1 OF 1
PLATE NO.
2-06

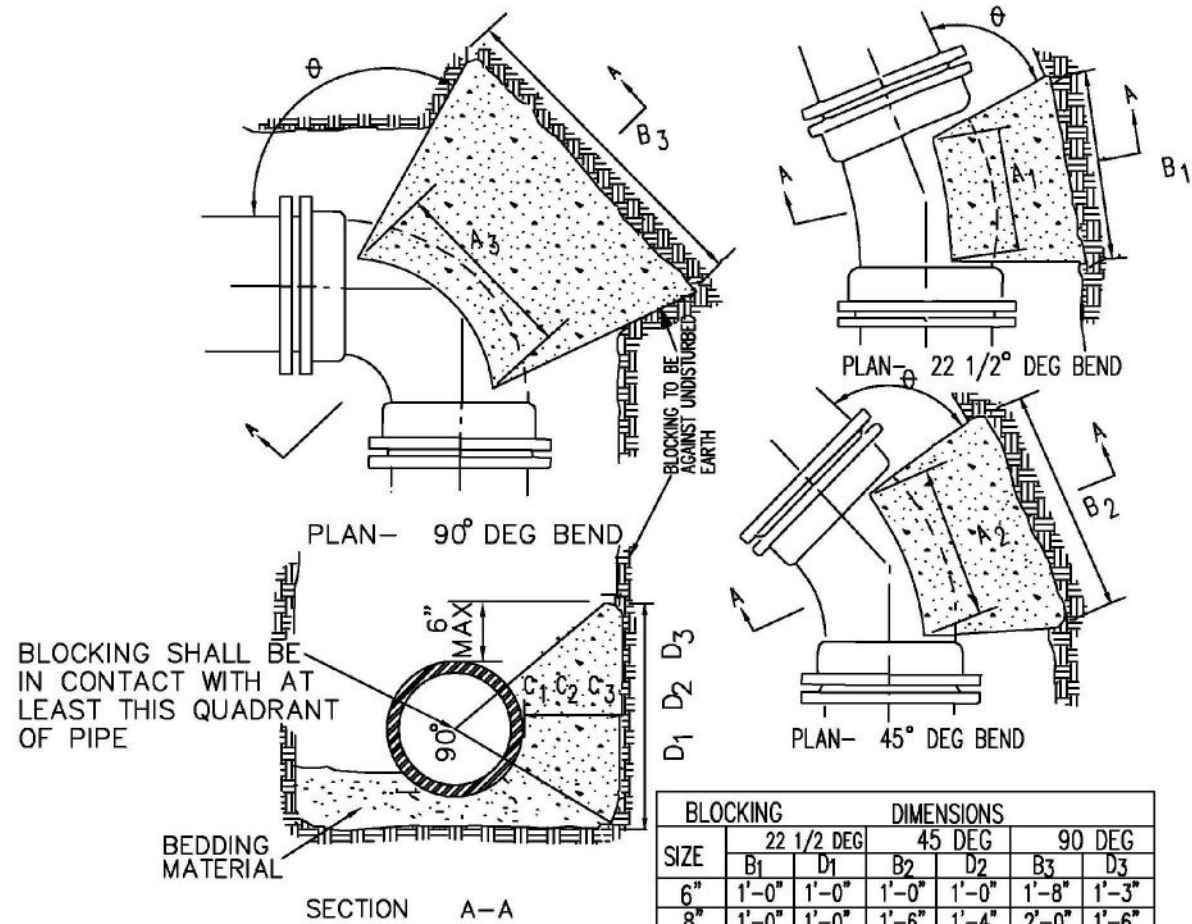


BLOCKING SIZE	DIMENSIONS					
	22 1/2 DEG		45 DEG		90 DEG	
	B1	D1	B2	D2	B3	D3
6"	1'-0"	1'-0"	1'-0"	1'-0"	1'-8"	1'-3"
8"	1'-0"	1'-0"	1'-6"	1'-4"	2'-0"	1'-6"
12"	1'-6"	1'-4"	2'-0"	2'-0"	3'-0"	2'-8"
16"	2'-0"	1'-8"	3'-0"	2'-6"	4'-0"	3'-10"

- NOTES:
- DIMENSIONS IN TABLE ARE BASED ON A WATER PRESSURE OF 150 PSI AND AN EARTH RESISTANCE OF TWO TONS PER SQ. FT.
 - DIMENSION C1, C2, C3, SHOULD BE LARGE ENOUGH TO MAKE ANGLE O EQUAL TO OR LARGER THAN 45 DEG.
 - DIMENSION A1, A2, A3 SHOULD BE AS LARGE AS POSSIBLE WITHOUT INTERFERING WITH MECHANICAL JOINT BOLTS.
 - SHAPE OF BACK OF CONCRETE BLOCKING MAY VARY AS LONG AS POUR IS AGAINST FIRM UNDISTURBED EARTH.
 - 5 BAG MIX CONCRETE TO BE USED FOR BLOCKING.
 - FOR LOSSE SANDY SOILS INCREASE ALL DIMENSIONS TO 6 INCHES.
 - PLACE 6MIL POLYETHYLENE FILM AROUND ALL BOLTS, NUTS, AND JOINTS.
- NOTE: REACTION BACKING USING CONCRETE, WOOD, RETAINER GLANDS, ROD TIES, ETC SHALL BE INCLUDED AS A PART OF INSTALLING THE WATERMAIN. NO SEPARATE COMPENSATION SHALL BE MADE.

NOT TO SCALE




THRUST BLOCKS

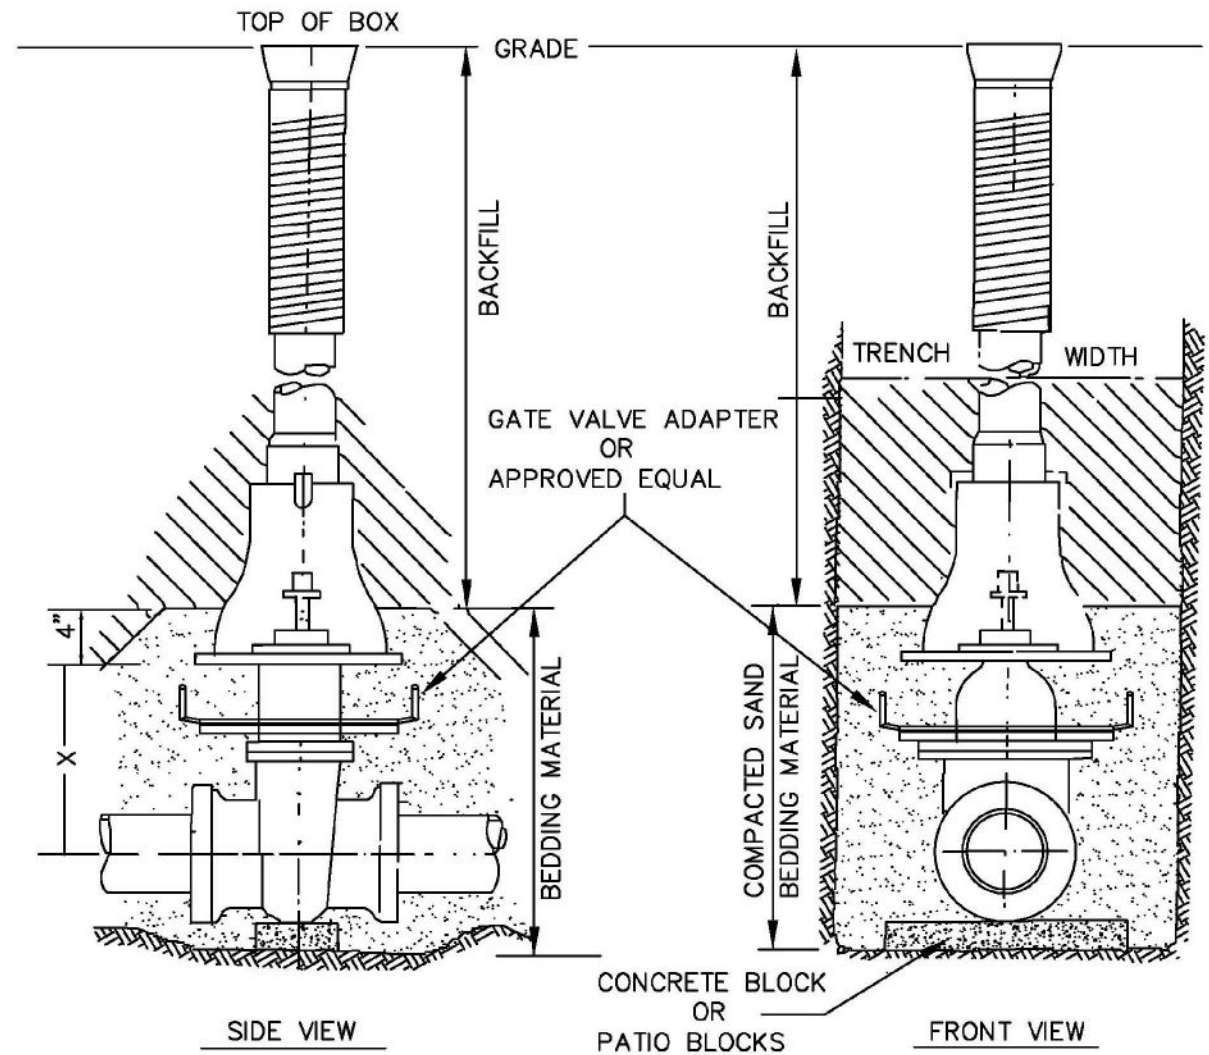

PIPE DIA. INCHES	X=SETTING INCHES
2	6
3	7
4	8
6	12
8	13
12	21
16	30

NOT TO SCALE

VALVE BOX

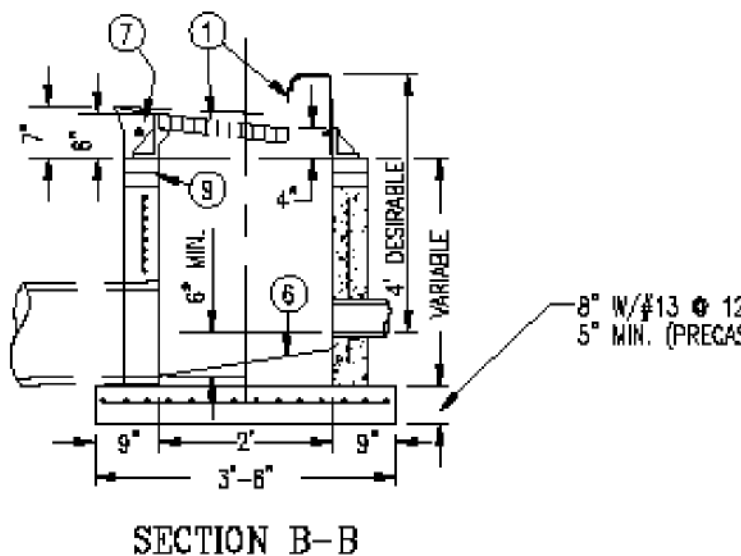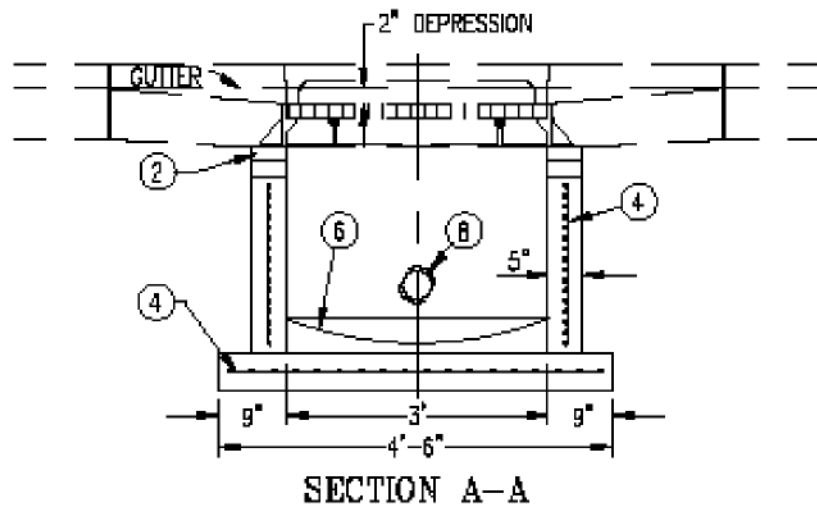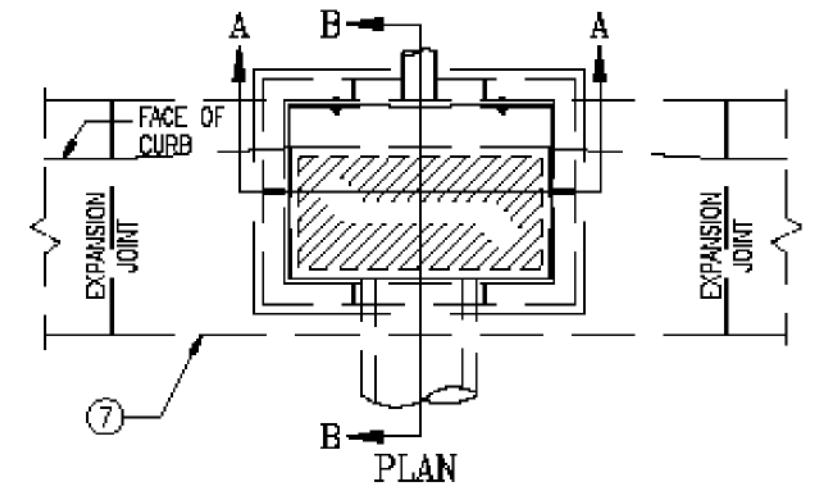

- NOTES**
- REFER TO PLANS AND S.D.P. 1-11 FOR TYPE OF FRAME, GRATE AND CURB BOX.
 - ADJ. RINGS SHALL BE PER S.D.P. 1-12, AND BE FULLY MORTARED. HEIGHT OF RINGS SHALL BE 2" MIN.-10" MAX. WITH 3 RINGS MAXIMUM.
 - STRUCTURE SHALL BE PRECAST CONCRETE.
 - REINFORCING SHALL BE A MINIMUM OF SINGLE LINE STEEL WIRE FABRIC HAVING AN AREA OF NOT LESS THAN 0.12 SQ. IN. PER FOOT EACH DIRECTION.
 - NO STEPS REQUIRED.
 - PROVIDE CONCRETE FILLETS TO FIT BOTTOM PORTION OF STRUCTURE AND TO DIRECT THE FLOW TO OUTLET AT MIN. SLDPE OF 1/4" PER FOOT. MINIMUM CONCRETE THICKNESS AT OUTLET 1 1/2".
 - SEE S.D.P. 2-01, 2-05 AND 2-06 FOR CURB, GUTTER AND REINFORCEMENT DETAILS AT CATCH BASINS.
 - 4" SUBDRAIN, IF SHOWN ON PLANS
 - USE PROTECTIVE COATING FROM CASTING TO 12" BELOW BOTTOM OF ADJUSTING RINGS. COATING SHALL CONFORM TO ASTM D-412. FINAL LINER MATERIAL SHALL BE NO LESS THAN 170 MILS THICK (BRUSHED) OR 80 MILS THICK (SPRAYED)

8" W/#13 @ 12" E.W. (CAST IN PLACE)
5" MIN. (PRECAST)

CASTINGS - STRUCTURE TYPE 1			
TYPE	DESCRIPTION	MEENAH REF. NO.	REMARKS
B	3" CURB INLET FRAME, GRATE & BOX	R-3067	DIAGONAL
C	3" DRIVEWAY INLET FRAME & GRATE	R-3280-A	PARALLEL (BICYCLE SAFE)
V	3" CURB INLET FRAME, GRATE & BOX	R-3067	PERPENDICULAR VANE

CASTINGS - OTHER STRUCTURES			
TYPE	DESCRIPTION	MEENAH REF. NO.	REMARKS
COVER	9" FRAME & COVER-T GASKETED	R-1916-C	USED IN FLOOD PRONE AREAS & IN CONCRETE PAVING
	9" FRAME & COVER-T GASKETED	R-1733-B	USED ON EXISTING STRUCTURE WITH HEIGHT CONSTRAINT
	7" FRAME & COVER-T GASKETED	R-1642	USED FOR P.R.V. MANHOLES
	7" FRAME & COVER-HIGH ROCKING OR T GASKET	R-1740-B	PAVEMENT DRAIN
GRATE	9" FRAME & GRATE-HIGH ROCKING OR T GASKET	R-2533	HEAVY DUTY
	DITCH GRATE-STOOL TYPE-TALL	R-4341-A	LIGHT DUTY
	DITCH GRATE-STOOL TYPE-SHORT	R-4342	LIGHT DUTY
	POND SKIMMER GRATE		HOT DIPPED GALVANIZED, HOT SUBJECT TO H2O LOADING

- NOTES:**
- CASTINGS SHALL BE ACCORDING TO MN/DOT SPEC 3321.1-2 SUPPLIED BY FOUNDRIES THAT ARE APPROVED ON THE MN/DOT APPROVED/QUALIFIED PRODUCTS LIST
 - ALL CASTINGS SHALL COMPLY WITH ASHTO M-306
 - ALL CASTINGS SHALL COMPLY WITH U.S. CODE OF FEDERAL REGULATIONS 23CFR633.410. THE "BUY AMERICAN STEEL & IRON" REGULATION
 - ALL STORM SEWER CASTINGS SHALL INCLUDE IMPRINT FISH STAMP AND "DUMP NO WASTE"
 - COVERS SHALL BE STAMPED FOR SPECIFIC UTILITY (EX. SANITARY SEWER).

wbks ENGINEERING, SURVEYING & PLANNING

STRUCTURE TYPE 1

REVISED: 2/01/08
SHEET: 1 OF 1
PLATE NO. 1-01

wbks ENGINEERING, SURVEYING & PLANNING

CASTING REFERENCE NUMBERS

REVISED: 12/31/19
SHEET: 1 OF 1
PLATE NO. 1-11

CASTINGS - STRUCTURE TYPE 1

TYPE	DESCRIPTION	A	B	C	D	E	F	G	Y	Z
B	3" CURB INLET FRAME, GRATE & BOX	43	31	1 15/16	4	6	11 5/16	5 3/4	35 1/4	17 3/4
C	3" DRIVEWAY INLET FRAME & GRATE	43	31	1 7/8	4	6			35 3/4	22 3/4
V	3" CURB INLET FRAME, GRATE & BOX	43	31	1 15/16	4	6	11 5/16	5 3/4	35 1/4	17 3/4


CASTINGS - STRUCTURE TYPE 1

TYPE	MINIMUM OPENING	GRATE SLOTS	REMARKS
B	1.56 SQ. FT.	DIAGONAL	
C	2.5 SQ. FT.	PARALLEL (BICYCLE SAFE)	USE WHERE DRIVEWAY PRECLUDES USE OF TYPE B IN BATTERFACE CURB
V	1.88 SQ. FT.	PERPENDICULAR VANE	USE WHEN STREET GRADE EXCEEDS 2%

NOTES:

- CASTINGS SHALL BE ACCORDING TO MN/DOT SPEC 3321.1-2 SUPPLIED BY FOUNDRIES THAT ARE APPROVED ON THE MN/DOT APPROVED/QUALIFIED PRODUCTS LIST
- ALL CASTINGS SHALL COMPLY WITH AASHTO M-306
- ALL CASTINGS SHALL COMPLY WITH U.S. CODE OF FEDERAL REGULATIONS 23CFR635.410, THE "BUY AMERICAN STEEL & IRON" REGULATION
- ALL STORM SEWER CASTINGS SHALL INCLUDE IMPRINT FISH STAMP AND "DUMP NO WASTE"

ALL DIMENSIONS ARE MINIMUM AND IN INCHES UNLESS OTHERWISE NOTED.

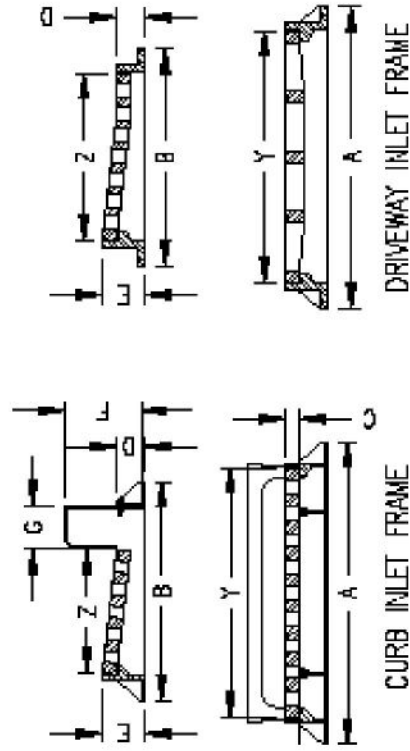

CURB INLET FRAME

DRIVEWAY INLET FRAME

CASTINGS - OTHER STRUCTURES

TYPE	DESCRIPTION	L	M	N	O	P	Q
1	9" FRAME & COVER-GASKETED	23	1 1/2	21	36	9	
2	9" FRAME & COVER-GASKETED	25 3/4	7/8	24	35 7/16	9	
3	7" FRAME & COVER-GASKETED	26	1 1/2	24 1/8	35 7/8	6 15/16	
4	7" FRAME & COVER-NON ROCKING	32	1 1/2	30	45 1/2	7	
5	9" FRAME & GRATE-NON ROCKING	22	1 1/2	20	33	8	
6	DITCH GRATE-STOOL TYPE-TALL	23	1 7/16		33		8 11/16
7	DITCH GRATE-STOOL TYPE-SHORT	23	1 1/2		33		6 5/8
8	POND SKIMMER GRATE	1/2" STEEL PLATE					1/2


ALL DIMENSIONS ARE MINIMUM AND IN INCHES UNLESS OTHERWISE NOTED.

CASTINGS - OTHER STRUCTURES

TYPE	MINIMUM OPENING	REMARKS
1		BOLTED LID, USED IN FLOOD PRONE AREAS & IN CONCRETE PAVING
2		WITH TWO CI PICK HOLES
3		WITH TWO CI PICK HOLES
4		USED FOR P.R.V. MANHOLES
5	1.1 SQ. FT.	PAVEMENT DRAIN
6	2.5 SQ. FT.	HEAVY DUTY
7	1.73 SQ. FT.	LIGHT DUTY
8	7.61 SQ. FT.	HOT DIPPED GALVANIZED, NOT SUBJECT TO H2O LEAKING

NOTES:

- CASTINGS SHALL BE ACCORDING TO MN/DOT SPEC. 3321.1-2 SUPPLIED BY FOUNDRIES THAT ARE APPROVED ON THE MN/DOT APPROVED/QUALIFIED PRODUCTS LIST
- ALL CASTINGS SHALL COMPLY WITH AASHTO M-306
- ALL CASTINGS SHALL COMPLY WITH U.S. CODE OF FEDERAL REGULATIONS 23CFR635.410, THE "BUY AMERICAN STEEL & IRON" REGULATION
- ALL STORM SEWER CASTINGS MAY INCLUDE IMPRINT FISH STAMP AND "DUMP NO WASTE"

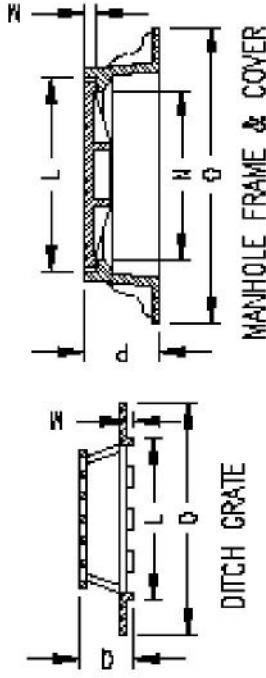

DITCH GRATE

MANHOLE FRAME & COVER



STANDARD CASTING ASSEMBLIES

REVISED:
12/31/19
SHEET:
1 OF 2
PLATE NO.
1-12




STANDARD CASTING ASSEMBLIES


REVISED:
12/31/19
SHEET:
2 OF 2
PLATE NO.
1-12

NOTE


ALL PIPE AND FITTINGS SHALL BE SDR26 WITH WATER TIGHT CONNECTIONS

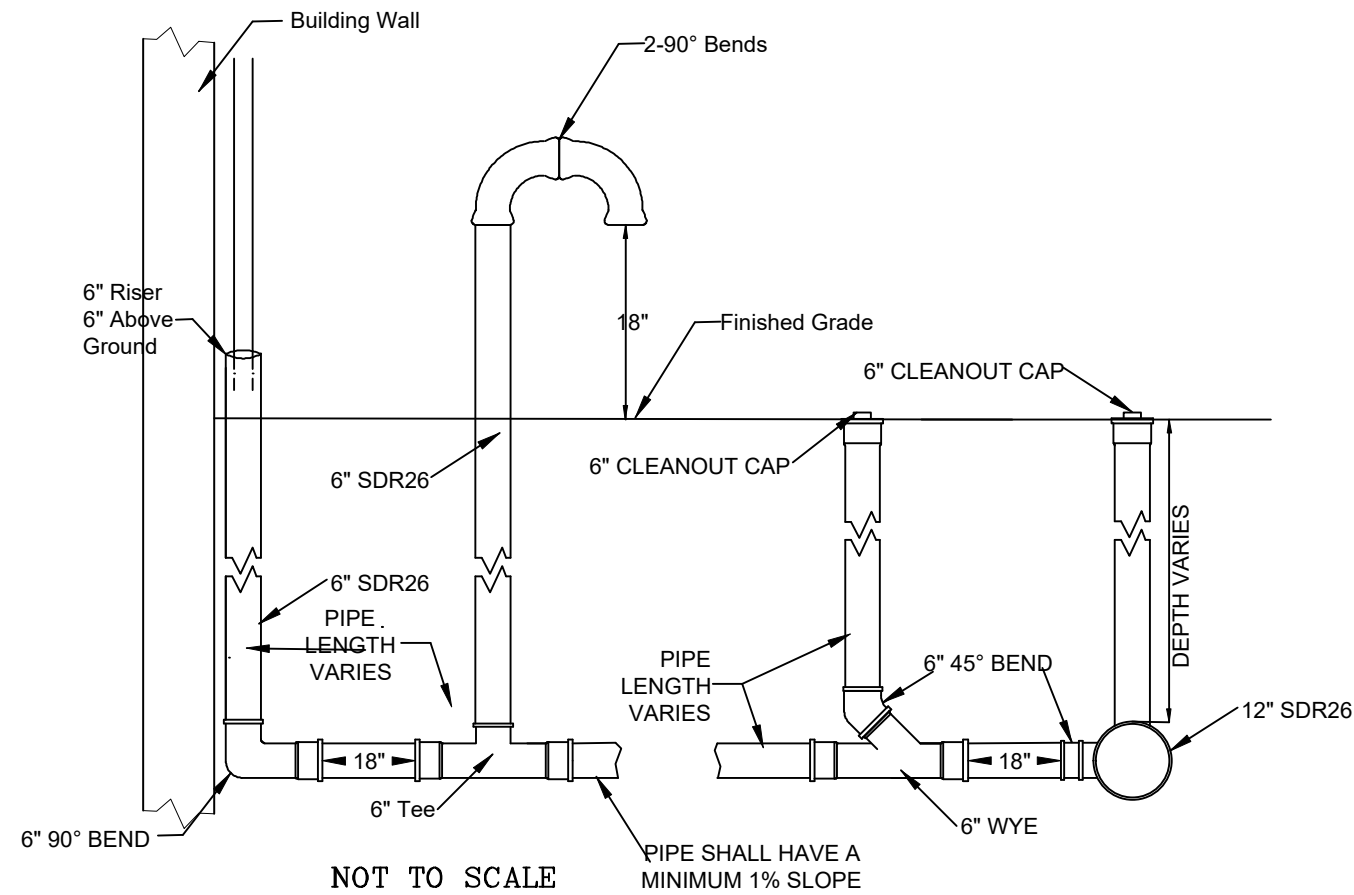

ROOF DRAIN CONNECTION

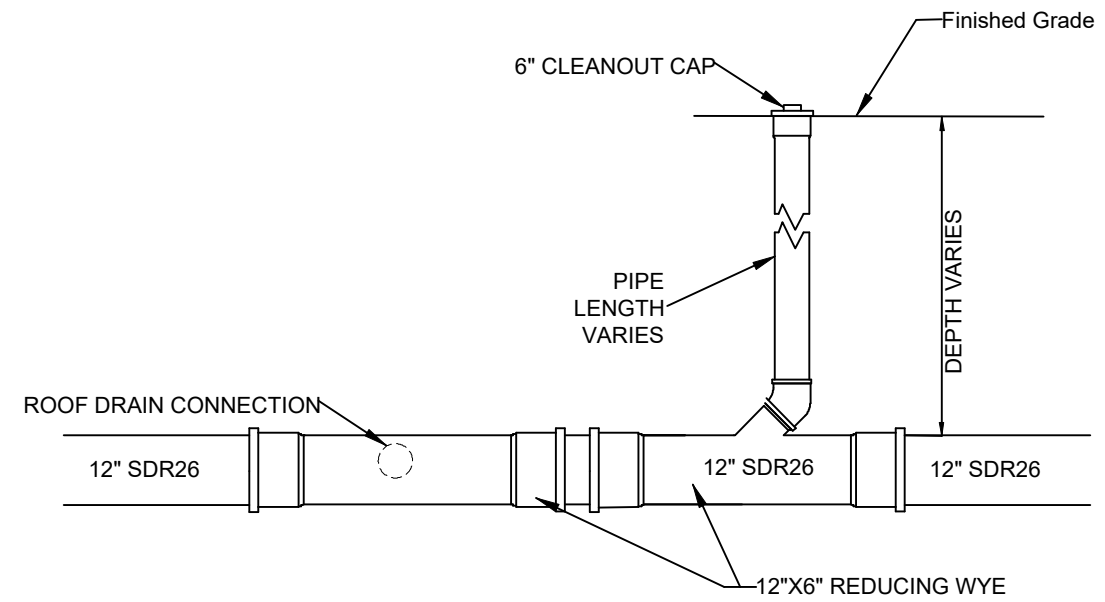

12" COLLECTOR PIPE AT ROOF DRAIN CONNECTION

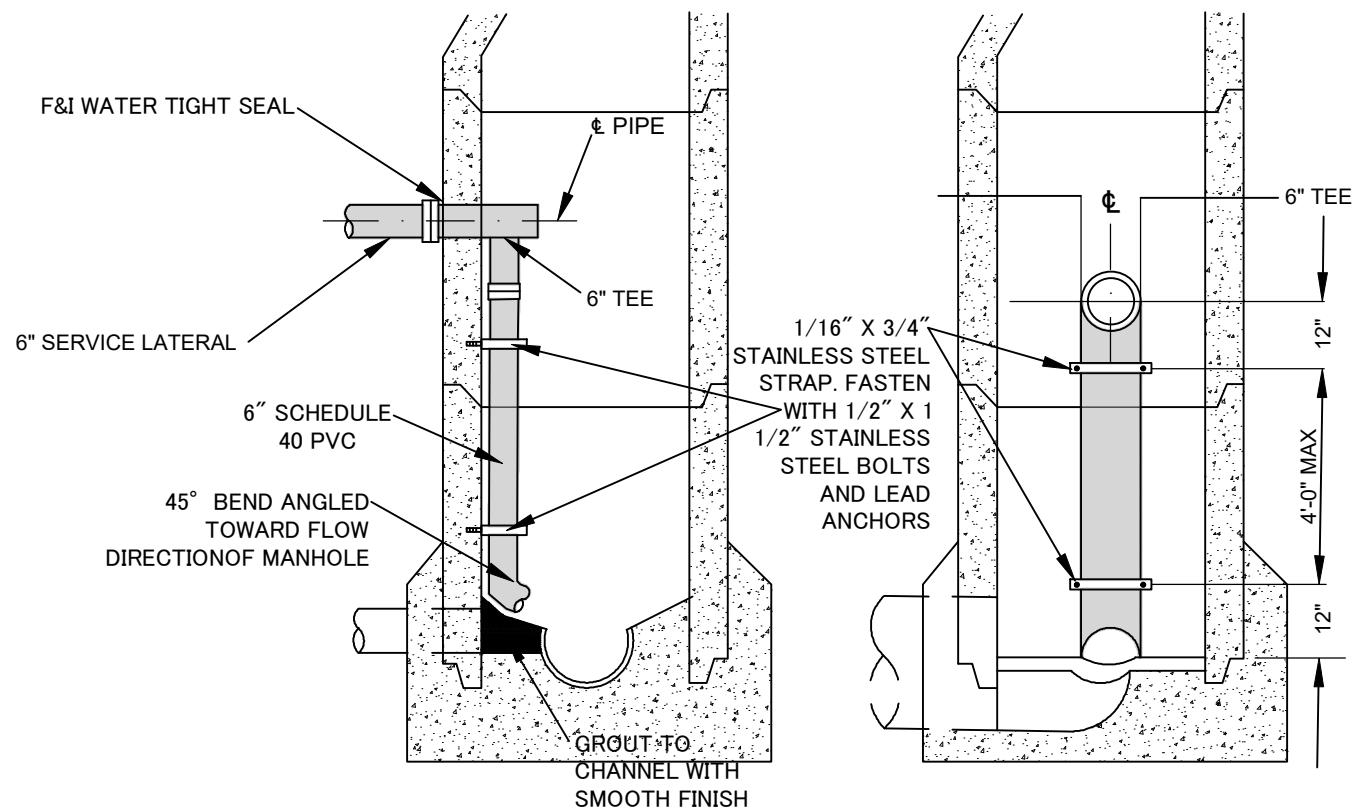


SIDE SECTION

FRONT SECTION

NOT TO SCALE

INSIDE DROP MANHOLE

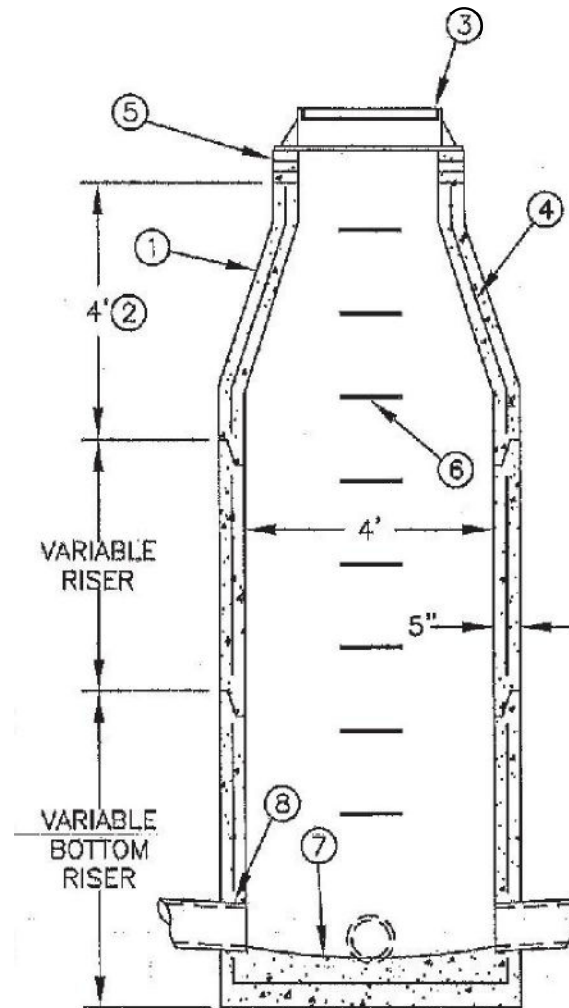

NOTES:

- ① CONE SHALL BE ECCENTRIC. MnDOT PLATE NO. 4005 TYPE B CONE SECTION.
- ② CONE SECTION HEIGHT MAY VARY AS REQUIRED FOR SPECIFIC MH.
- ③ REFER TO PLANS AND/OR SPECIAL PROVISIONS FOR FRAME AND LID TYPE.
- ④ REINFORCING SHALL BE A MINIMUM OF SINGLE LINE STEEL WIRE FABRIC HAVING AN AREA OF NOT LESS THAN 0.12 SQ. IN. PER FOOT IN EACH DIRECTION.
- ⑤ HIGH DENSITY POLYETHYLENE ADJUSTING RINGS SHALL BE INSTALLED PER MANUFACTURER'S RECOMMENDATIONS STARTING ON A SOLID, CLEANED CONE SECTION OF THE INPLACE MANHOLE. THE OUTSIDE OF THE ENTIRE RING SECTION SHALL BE SEALED TO THE STRUCTURE WITH A UNI-BAND (RUBBER) SEALING SYSTEM.
- ⑥ STEPS, ORIENTED ON THE UPSTREAM SIDE OF THE MH, ARE SPACED 16" O.C. AND SHALL CONFORM TO MnDOT PLATE NO. 4180.
- ⑦ MONOLITHIC BASE AND INVERTS SUBJECT TO APPROVAL BY THE ENGINEER. FIELD POURED INVERTS AND/OR SEPARATE BASE SLAB MAY BE REQUIRED IN SOME INSTANCES. INVERT CHANNEL DEPTH SHALL NOT BE LESS THAN 1/2 THE PIPE SIZE.
- ⑧ WATER TIGHT SEAL SHALL CONFORM TO MnDOT PLATE NO. 4007.

NOT TO SCALE

SANITARY SEWER MANHOLE

Engineering, Surveying & Planning
JOHNSON & SCOFIELD INC.
 1203 Main Street Red Wing, MN 55066
 ph. 651.388.1558 fax 651.388.1559

I HEREBY CERTIFY THAT THIS PLAN, SPECIFICATION, OR REPORT WAS PREPARED BY ME OR UNDER MY DIRECT SUPERVISION AND I AM A DULY LICENSED PROFESSIONAL ENGINEER UNDER THE LAWS OF THE STATE OF MINNESOTA.
 Steven P. Voigt, PE
 DATE 3-3-2021 REG. NO. 20034

DESIGNED	BY	DATE
SPD\SPV	SPD	3/11/2021
DRAWN	SPD	
CHECKED	SPV	

LATEST REVISION: 3-11-21
 Prepared For:
 ANDY BAARTMAN
 A-1 CLEANING
 P.O.B. 31
 RED WING, MN 55066
 PHONE: 651-301-6103


ZUMBROTA APARTMENTS

DETAILS

ZUMBROTA, MN

SHEET 28 OF 29 SHEETS

PRE DEVELOPMENT RUNOFF

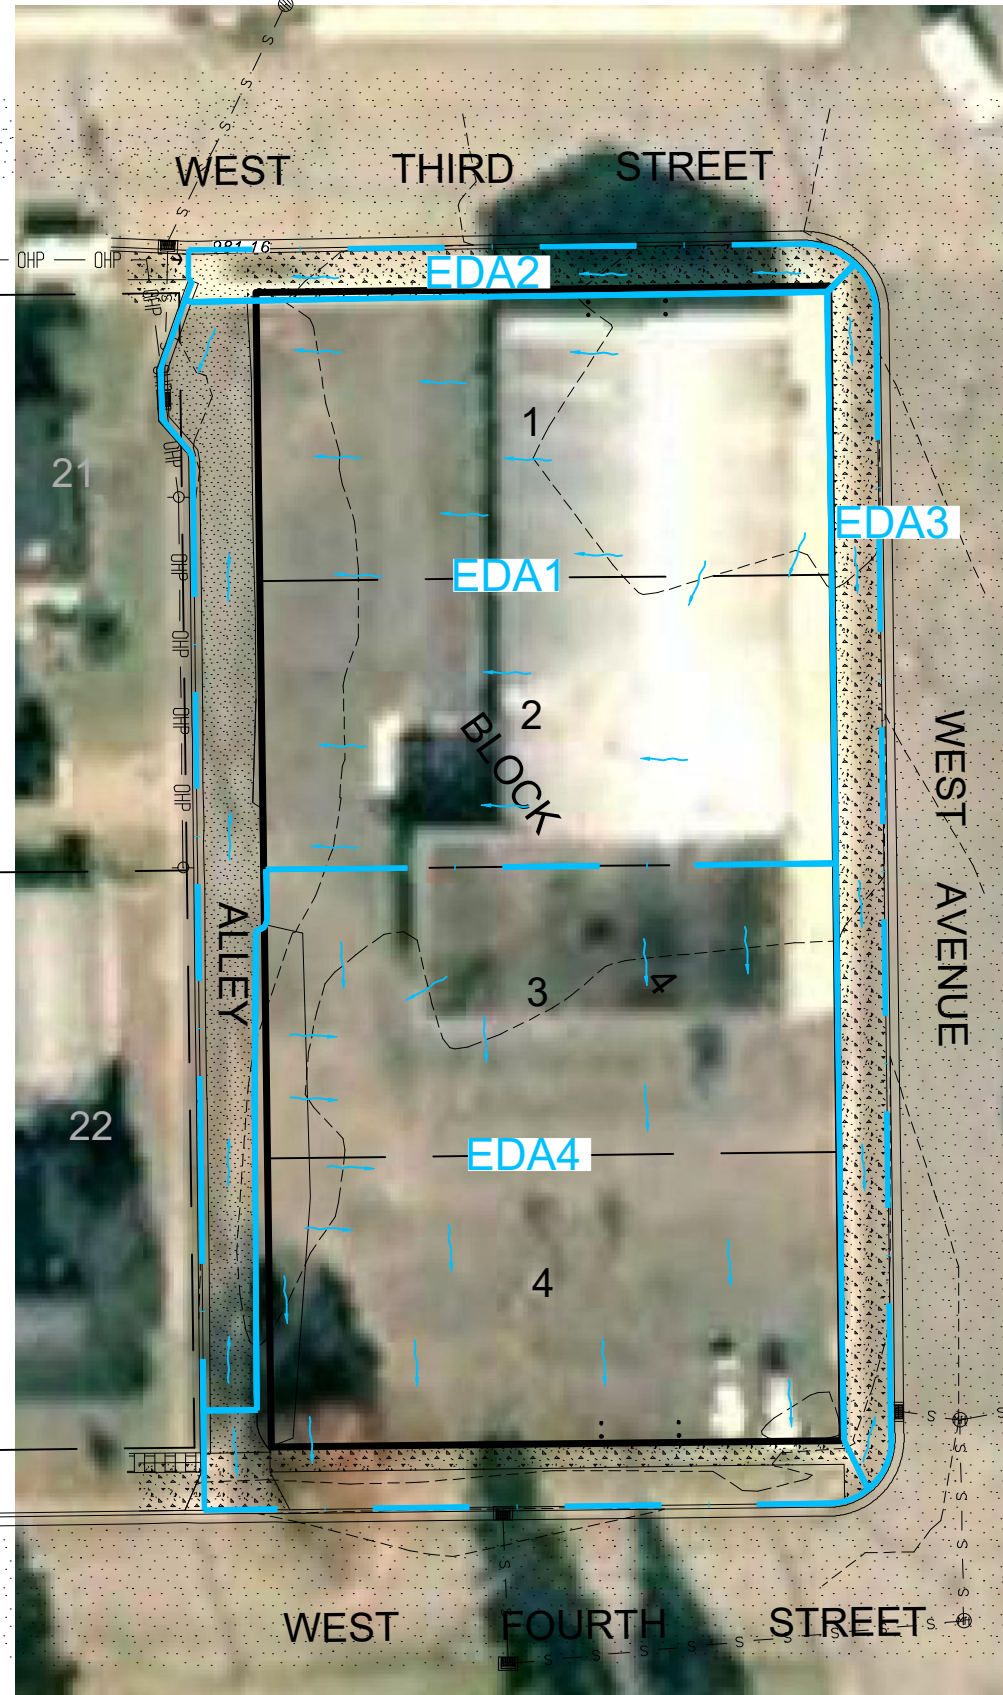

LEGEND


- DENOTES EXISTING DRAINAGE AREA
- DENOTES EXISTING DRAINAGE AREA FLOW PATH
- DENOTES SURFACE WATER FLOW DIRECTION
- DENOTES PROPOSED DRAINAGE AREA
- DENOTES PROPOSED DRAINAGE AREA FLOW PATH

CONTRIBUTING DRAINAGE AREAS			
EDA1 0.396 ACRES 0.396 ACRES IMPERVIOUS TCL: 410 FT AV SLOPE = 2.38% CN = 98 LFP = 224 FT TC = 2.9 MIN	EDA2 0.032 ACRES 0.032 ACRES IMPERVIOUS TCL: 62 FT AV SLOPE = 4.38% CN = 98 LFP = 157 FT TC = 1.6 MIN	EDA3 0.057 ACRES 0.057 ACRES IMPERVIOUS TCL: 58 FT AV SLOPE = 2.34% CN = 98 LFP = 248 FT TC = 3.2 MIN	EDA4 0.378 ACRES 0.378 ACRES IMPERVIOUS TCL: 454 FT AV SLOPE = 2.76% CN = 98 LFP = 208 FT TC = 2.6 MIN
PDA1 0.20 ACRES 0.17 ACRES IMPERVIOUS TCL: 325 FT AV SLOPE = 3.81% AV CN = 68.5 LFP = 230 FT TC = 3.7 MIN	PDA2 0.12 ACRES 0.11 ACRES IMPERVIOUS TCL: 325 FT AV SLOPE = 2.50% AV CN = 68.5 LFP = 134 FT TC = 2.5 MIN	PDA3 0.25 ACRES 0.21 ACRES IMPERVIOUS TCL: 2539 FT AV SLOPE = 2.33% AV CN = 68.5 LFP = 238 FT TC = 4.8 MIN	PDA4 0.28 ACRES 0.27 ACRES IMPERVIOUS TCL: 3653 FT AV SLOPE = 2.91% AV CN = 68.5 LFP = 264 FT TC = 3.4 MIN
TOTAL DRAINAGE AREA= 0.863 ACRES EXISTING CONDITIONS HISTORICAL IMPERVIOUS AREA= 0.863 ACRES (100%) PROPOSED IMPERVIOUS AREA= 0.76 ACRES (88.06%) DECREASE OF IMPERVIOUS AREA FROM HISTORICAL= 0.103 ACRES			
PRE DEVELOPMENT RUNOFF			
DA	Q2 CFS	Q10 CFS	Q100 CFS
1	1.88	2.90	5.12
2	0.15	0.24	0.42
3	0.27	0.41	0.73
4	1.81	2.80	4.94
EXISTING CONDITIONS HISTORICAL IMPERVIOUS	4.11	6.35	11.21
POST DEVELOPMENT RUNOFF			
DA	Q2 CFS	Q10 CFS	Q100 CFS
1	0.71	1.23	2.36
2	0.52	0.84	1.54
3	0.84	1.46	2.80
4	1.25	1.97	3.52
TOTAL POST DEVELOPMENT RUNOFF*	3.32	5.50	10.22
DEVELOPMENT RUNOFF SUMMARY			
	Q2 CFS	Q10 CFS	Q100 CFS
EXISTING CONDITIONS HISTORICAL IMPERVIOUS	4.11	6.35	11.21
TOTAL POST DEVELOPMENT RUNOFF*	3.32	5.50	10.22
TOTAL CHANGE (DECREASE)	0.79	0.85	0.99

HYDROLOGY NOTES

- HYDROLOGY CALCULATIONS ONLY INCLUDE THE DRAINAGE AREAS SHOWN
- TOTAL DEVELOPMENT RUNOFF IS CALCULATED USING NULL NODE IN HYDROCAD
- ALL SOILS ON SITE ARE "B" TYPE SOILS WITH POORLY GRADED SAND UNDER APPROXIMATELY 2 FEET OF SLIGHTLY ORGANIC SANDY SILT, LEAN CLAY, AND SILTY SAND. SEE SOIL BORING LOGS.

POST DEVELOPMENT RUNOFF

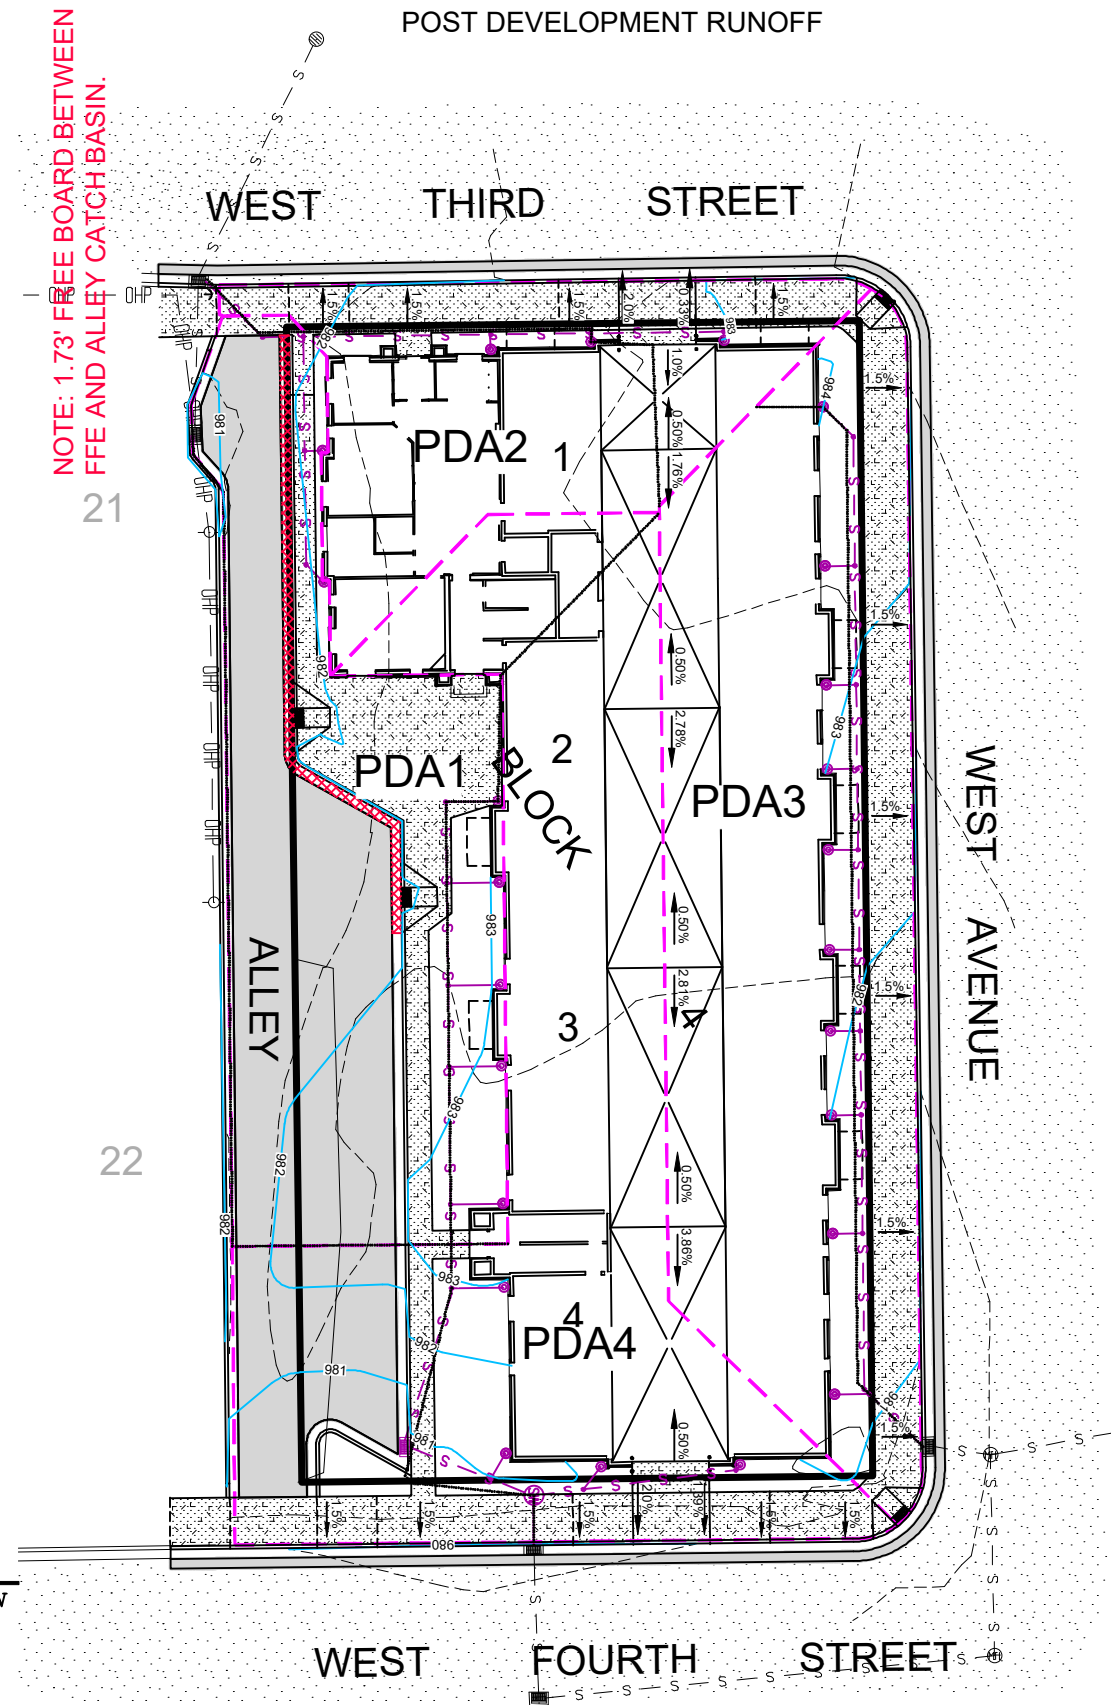

Engineering, Surveying & Planning
JOHNSON & SCOFIELD INC.
1203 Main Street Red Wing, MN 55066
ph. 651.388.1558 fax 651.388.1559

I HEREBY CERTIFY THAT THIS PLAN, SPECIFICATION, OR REPORT WAS PREPARED BY ME OR UNDER MY DIRECT SUPERVISION AND I AM A DULY LICENSED PROFESSIONAL ENGINEER UNDER THE LAWS OF THE STATE OF MINNESOTA
Steven P. Voigt, PE
Steven P. Voigt, PE
DATE 3-3-2021 REG. NO. 20034

DESIGNED SPD\SPV
DRAWN SPD
CHECKED SPV

REVISED	BY	DATE
ADDENDUM #2	SPD	3/11/2021

LATEST REVISION: 3-11-21
Prepared For:
ANDY BAARTMAN
A-1 CLEANING
P.O.B. 31
RED WING, MN 55066
PHONE: 651-301-5103

ZUMBROTA APARTMENTS
ZUMBROTA, MN

EXISTING AND PROPOSED HYDRAULIC CONDITIONS
SHEET 29 OF 29 SHEETS